STRATA PLAN OF LOT D, DISTRICT LOT 95, GROUP 1, N.W.D., PLAN BCP6930

"CITY OF BURNABY"
B.C.G.S. 92G.026

STRATA PLAN BCS 2855

DEPOSITED AND REGISTERED IN THE LAND TITLE OFFICE AT NEW WESTMINSTER, B.C.
THIS 16 DAY OF APRIL, 2008.
IAN MAC DONALD/CP
REGISTRAR

BB652544-756

"WEST AT HIGHGATE VILLAGE"
7088 SALISBURY AVENUE
BURNABY, BC

SCALE 1:600
10 0 10 20
ALL DISTANCES ARE IN METRES.

INTEGRATED SURVEY AREA No. 25 (BURNABY) NAD-83 (CSRS)

THIS PLAN SHOWS HORIZONTAL GROUND-LEVEL MEASURED DISTANCES EXCEPT WHERE OTHERWISE NOTED. TO COMPUTE GRID DISTANCES, MULTIPLY GROUND LEVEL DISTANCES BY COMBINED FACTOR 0.99958395

SEE SHEET #2 FOR BOUNDARY DIMENSIONS

SEE SHEET #3 FOR BUILDING LOCATION AND DIMENSIONS

NOTE:
ALL BOUNDARIES OF STRATA LOTS ARE PARALLEL TO, PERPENDICULAR TO, OR AT 45° DEFLECTION TO, UNLESS OTHERWISE SHOWN.

NOTE:
THIS STRATA PLAN DOES NOT HAVE A FOURTH AND A THIRTEENTH FLOOR.

NOTE:
STRATA LOT BOUNDARIES ARE DEFINED AS CENTER LINE OF WALL FOR DEMISING WALLS OF STRATA LOTS AND 0.025 METRES (ONE INCH) INSIDE ALL EXTERIOR WALLS OF STRATA LOTS.

THIS STRATA PLAN CONTAINS LIMITED COMMON PROPERTY ACCORDING TO SEC. 73 (a)(i) OF THE STRATA PROPERTY ACT.

I, MIKE E. SHAW, A BRITISH COLUMBIA LAND SURVEYOR CERTIFY THAT THE BUILDING SHOWN ON THIS STRATA PLAN IS WITHIN THE THE EXTERNAL BOUNDARIES OF THE LAND THAT IS THE SUBJECT OF THE STRATA PLAN.

DATE: FEBRUARY 20th, 2008.

Mike E Shaw

BENNETT LAND SURVEYING LTD.
B.C. & CANADA LAND SURVEYORS
#201-9547 152nd STREET,
SURREY, B.C. V3R 5Y5
PHONE : 604-582-0717

DRAWING # 30624-10
FILE # 30624-10_FS
DATE : FEBRUARY 20, 2008

THIS PLAN LIES WITHIN THE GREATER VANCOUVER REGIONAL DISTRICT

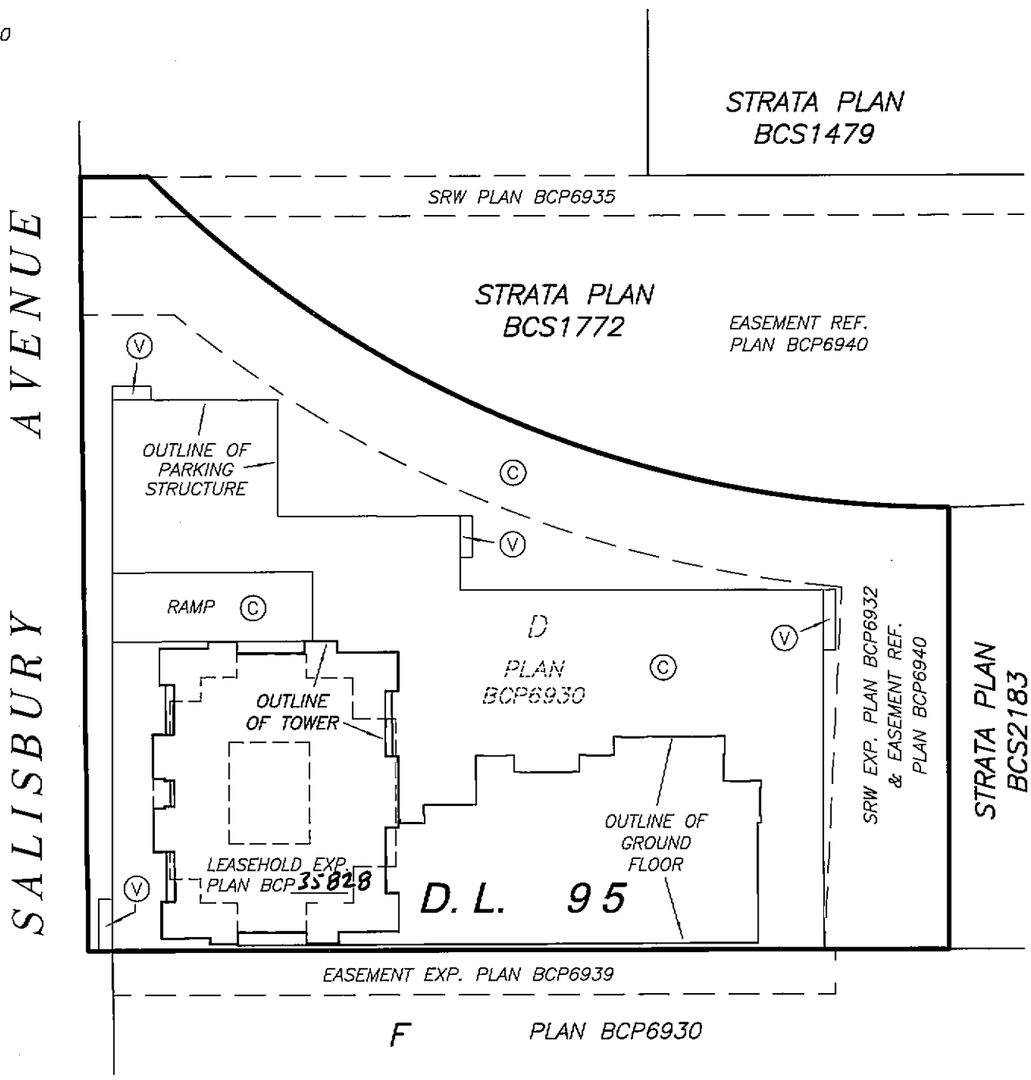

LEGEND

GRID BEARINGS ARE DERIVED FROM OBSERVATIONS BETWEEN CONTROL MONUMENTS 94H1720 AND 94H1479

- ▲ – DENOTES CONTROL MONUMENT FOUND
- ■ – DENOTES LEAD PLUG FOUND
- □ – DENOTES LEAD PLUG PLACED
- ● – DENOTES STANDARD IRON POST FOUND
- ○ – DENOTES STANDARD IRON POST PLACED
- NR – DENOTES NO RECORD
- D/R – DENOTES DESTROYED/RESET
- SL. – DENOTES STRATA LOT
- PT. – DENOTES PART
- (C) – DENOTES COMMON PROPERTY
- (E) – DENOTES ELECTRICAL ROOM BEING COMMON PROPERTY
- (ES) – DENOTES ELECTRICAL SHAFT BEING COMMON PROPERTY
- (V) – DENOTES VENT BEING COMMON PROPERTY
- (MS) – DENOTES MECHANICAL SPACE BEING COMMON PROPERTY
- (P1) TYPICAL – DENOTES PATIO BEING LIMITED COMMON PROPERTY FOR THE EXCLUSIVE USE OF SL. 1
- (T53) TYPICAL – DENOTES TERRACE BEING LIMITED COMMON PROPERTY FOR THE EXCLUSIVE USE OF SL. 53
- (B6) TYPICAL – DENOTES BALCONY BEING LIMITED COMMON PROPERTY FOR THE EXCLUSIVE USE OF SL. 6

ORIGINAL

FILED NWBCS2855 RCVD:2008-04-16 RQST:2010-03-09-14.00.13.395

BOUNDARY DIMENSIONS

STRATA PLAN BCS 2855

SCALE 1:500

10 0 10 20

ALL DISTANCES ARE IN METRES.

COLLIER STREET

SALISBURY AVENUE

STRATA PLAN BCS1772

STRATA PLAN BCS1479

STRATA PLAN BCS2183

LOT D PLAN BCP6930

F PLAN BCP6930

43.786

41"

45°20'04"

90°10'28"

6.807

SRW PLAN BCP 6935

94H1720

EASEMENT REF. PLAN BCP 6940

r=113.274

d=89.281

SRW PLAN BCP 6932

35"

53'

241.875

45"

Wt.

0.05

03"

163.000

08'

34'

359°

77.804

LEASEHOLD EXP. PLAN BCP35828

(RADIAL)

28"

44.399

EASEMENT REF. PLAN BCP6940

326"

DESTROYED 94H1479

10'

275.729

73° 41' 55"

D/R

86.317

90°

10'

28"

0'

15.00

Wt.

17"

EASEMENT EXP. PLAN BCP 6939

EASEMENT EXP. PLAN BCP 6939

SRW PLAN BCP6934

56'

420.615

60°

87H3321

I, MIKE E. SHAW, A BRITISH COLUMBIA LAND SURVEYOR, OF LANGLEY, IN BRITISH COLUMBIA, CERTIFY THAT I WAS PRESENT AT AND PERSONALLY SUPERINTENDED THE SURVEY REPRESENTED BY THIS PLAN, AND THAT THE SURVEY AND PLAN ARE CORRECT. THE FIELD SURVEY WAS COMPLETED ON THE 4th DAY OF FEBRUARY, 2008. THE PLAN WAS COMPLETED AND CHECKED, AND THE CHECKLIST FILED UNDER # ECP77788, 29th DAY OF FEBRUARY, 2008.

Mike E Shaw B.C.L.S.

DATE : FEBRUARY 20, 2008

M.E.S.

DRAWING # 30624-10
FILE # 30624-10_Post

ORIGINAL

FILED NWBCS2855 RCVD:2008-04-16 RQST:2010-03-09-14.00.13.395

BUILDING LOCATION AND DIMENSIONS

STRATA PLAN BCS 2855

SCALE 1:400

5 0 5 10 15

ALL DISTANCES ARE IN METRES.

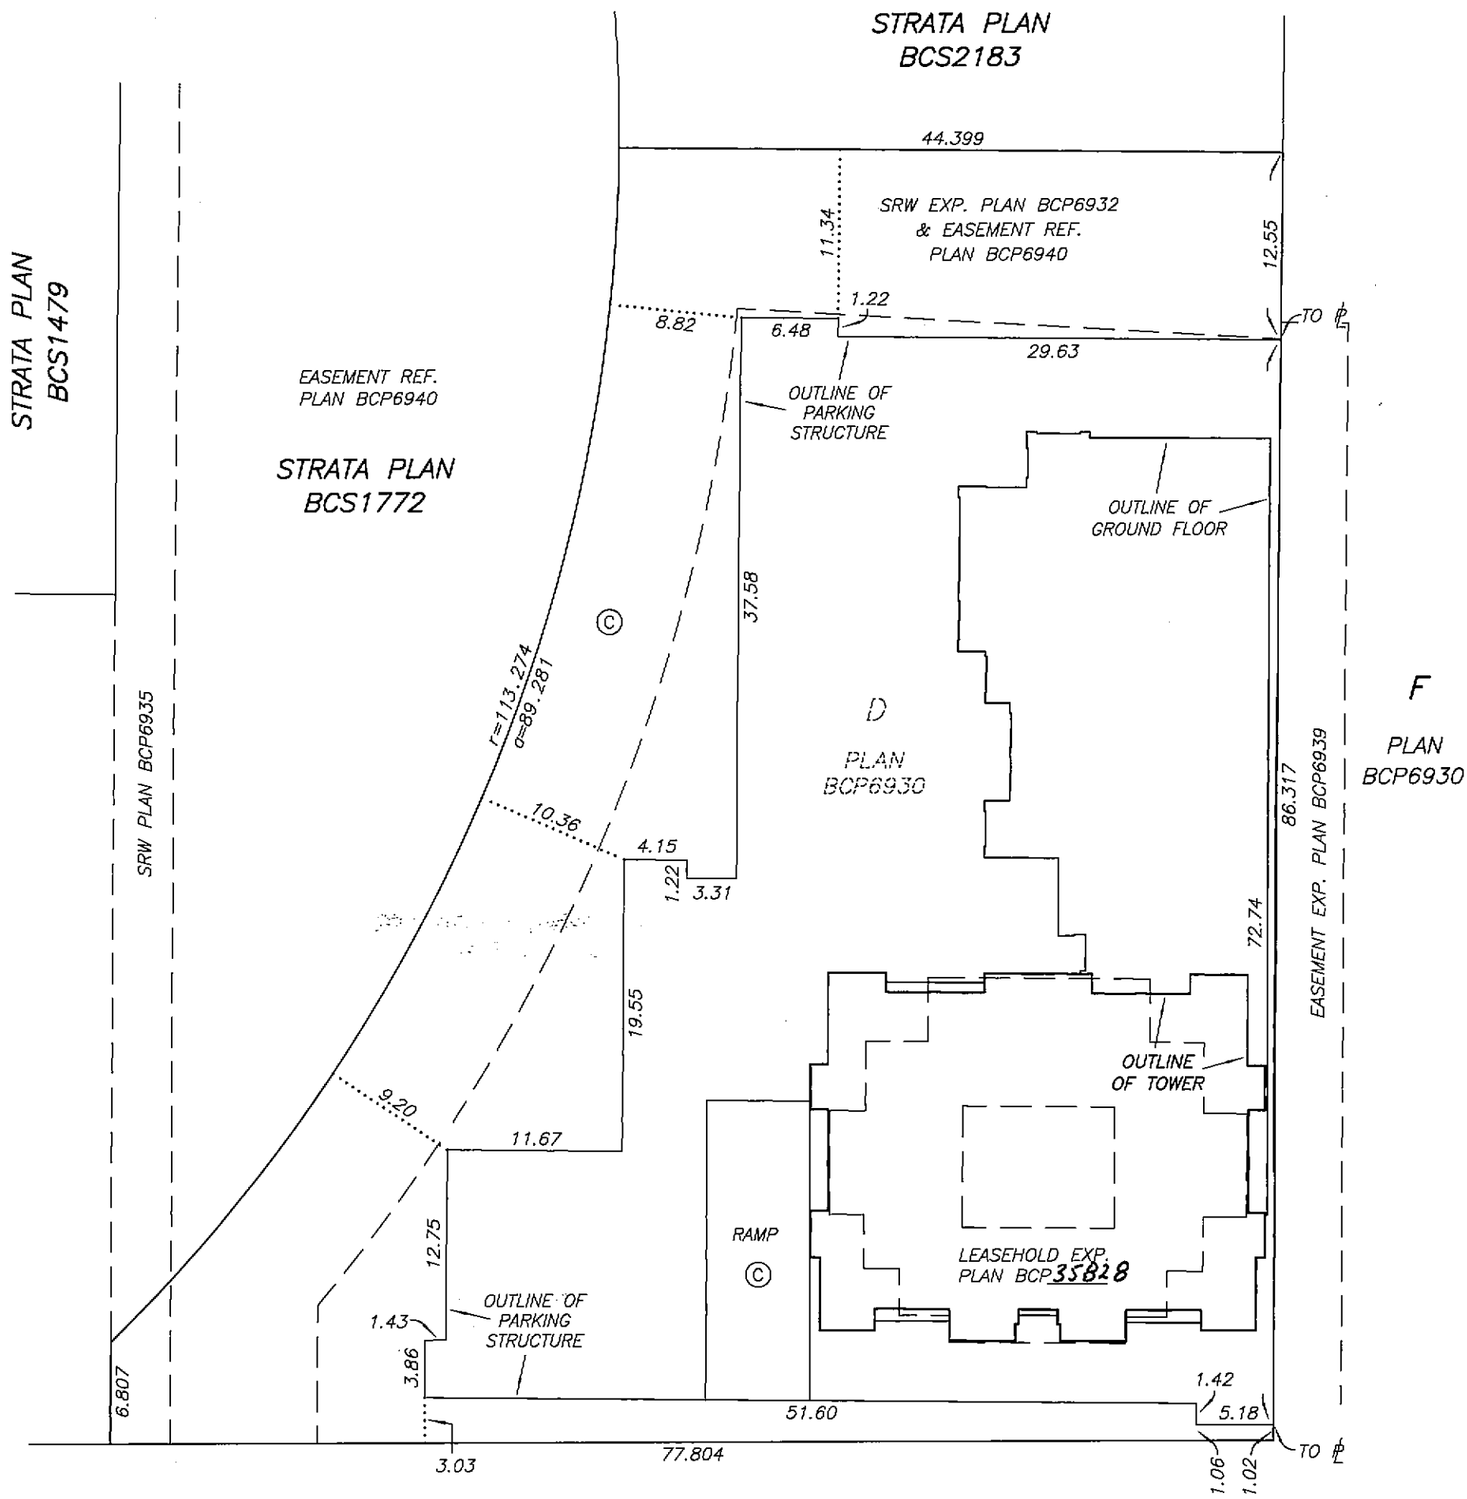

SALISBURY AVENUE

DATE : FEBRUARY 20, 2008

M.E.B.

DRAWING # 30624-10
FILE # 30624-10_Ce

ORIGINAL

FILED NMBCS2855 RCVD:2008-04-16 RQST:2010-03-09-14.00.13.395

STRATA PLAN BCS 2855

OWNER :

BOSA PROPERTIES (HIGHGATE) INC.
INCORPORATION No. 636666

AUTHORIZED SIGNATORY DALE BOSA

~~AUTHORIZED SIGNATORY~~

WITNESS AS TO ~~BOTH~~ SIGNATURES
DIRK C.A. DE VUYST
SOLICITOR
OCCUPATION OF WITNESS
1801-4555 KINGSWAY
BURNABY, B.C. V5H 4T8
ADDRESS OF WITNESS

MORTGAGEE :

BCIMC CONSTRUCTION FUND CORPORATION
(INCORPORATION No. BC0716305)

AUTHORIZED SIGNATORY Margot Gunn

~~AUTHORIZED SIGNATORY~~

WITNESS AS TO BOTH SIGNATURES Carol Aston
Mortgage Technician
OCCUPATION OF WITNESS
2940 Jutland Road, Victoria
ADDRESS OF WITNESS
V8T 5K6

THE CITY OF BURNABY REGISTERED OWNER OF COVENANTS BV335847, BV335849, BV335851, BV335860, BV335863, BV335867,BV335869, BV335871, BW61092, BW61094 AND BW549351 HEREBY CONSENTS TO THE DEPOSIT OF THIS PLAN.

AUTHORIZED SIGNATORY
DEBBIE R. COMIS
City Clerk

AUTHORIZED SIGNATORY

MORTGAGEE :

CANADIAN IMPERIAL BANK OF COMMERCE

AUTHORIZED SIGNATORY SAM BEIZTUCCI
Senior Risk Analyst

AUTHORIZED SIGNATORY ANN marie merrick
ASSt. General Manager

WITNESS AS TO BOTH SIGNATURES
ADITY NANDINI SHIVNARAIN
OCCUPATION OF WITNESS
Notary for the Province of Ontario
ADDRESS OF WITNESS
595 Bay St 5th floor
Toronto, ont M5G 2C2

I, MIKE E. SHAW, A BRITISH COLUMBIA LAND SURVEYOR, CERTIFY THAT THE BUILDING INCLUDED IN THIS STRATA PLAN HAS NOT, AS OF FEBRUARY 20th , 2008, BEEN PREVIOUSLY OCCUPIED.

Mike E Shaw B.C.L.S.

DATE : FEBRUARY 20, 2008
M.E.S.

DRAWING # 30624-10
FILE # 30624-10_Sign

ORIGINAL

FILED NWBCS2855 RCVD:2008-04-16 RQST:2010-03-09-14.00.13.395

FILED NWBCS2855 RCVD:2008-04-16 RQST:2010-03-09-14.00.13.395

STRATA PLAN BCS 2855

DATE : FEBRUARY 20, 2008

ORIGINAL

SECTION A – A'

SCALE 1:250

4 0 4 8

ALL DISTANCES ARE IN METRES.

DRAWING # 30624-10
FILE # 30624-10_S

SECTION A – A'

STRATA PLAN BCS 2855

SCALE 1:150

2 0 2 4 6

ALL DISTANCES ARE IN METRES.

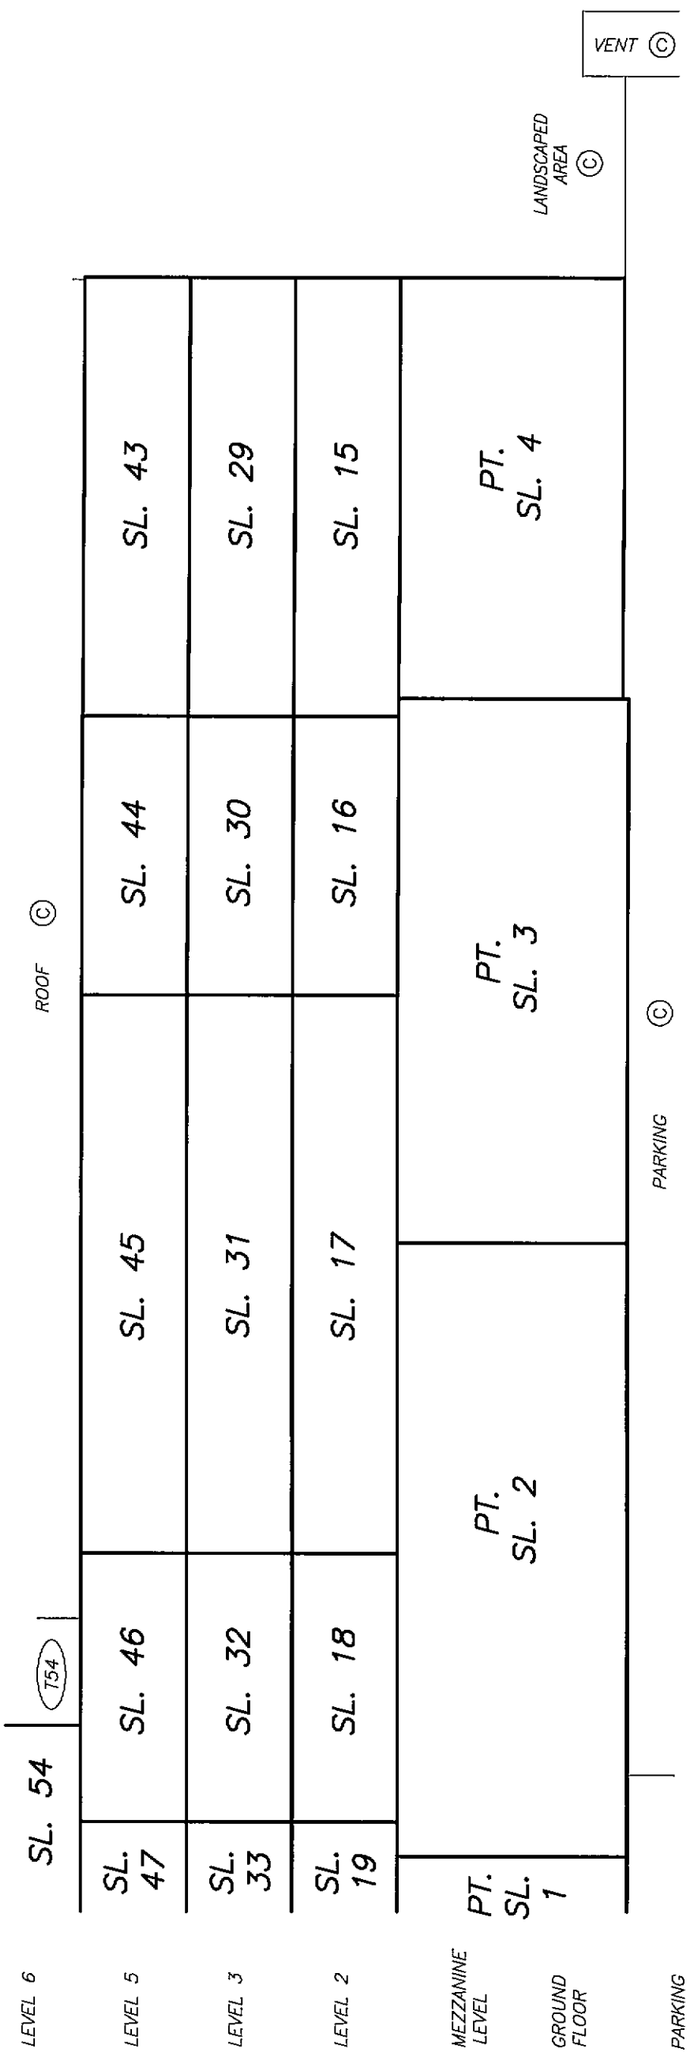

SEE SHEET #5 FOR CONTINUATION

SEE SHEET #7 FOR CONTINUATION

DATE : FEBRUARY 20, 2008

M.E.S.

DRAWING # 30624-10
FILE # 30624-10_Sa

ORIGINAL

FILED NWBCS2855 RCVD:2008-04-16 RQST:2010-03-09-14.00.13.395

SECTION A – A'

STRATA PLAN BCS 2855

SCALE 1:150

2 0 2 4 6

ALL DISTANCES ARE IN METRES.

SEE SHEET #8
FOR CONTINUATION

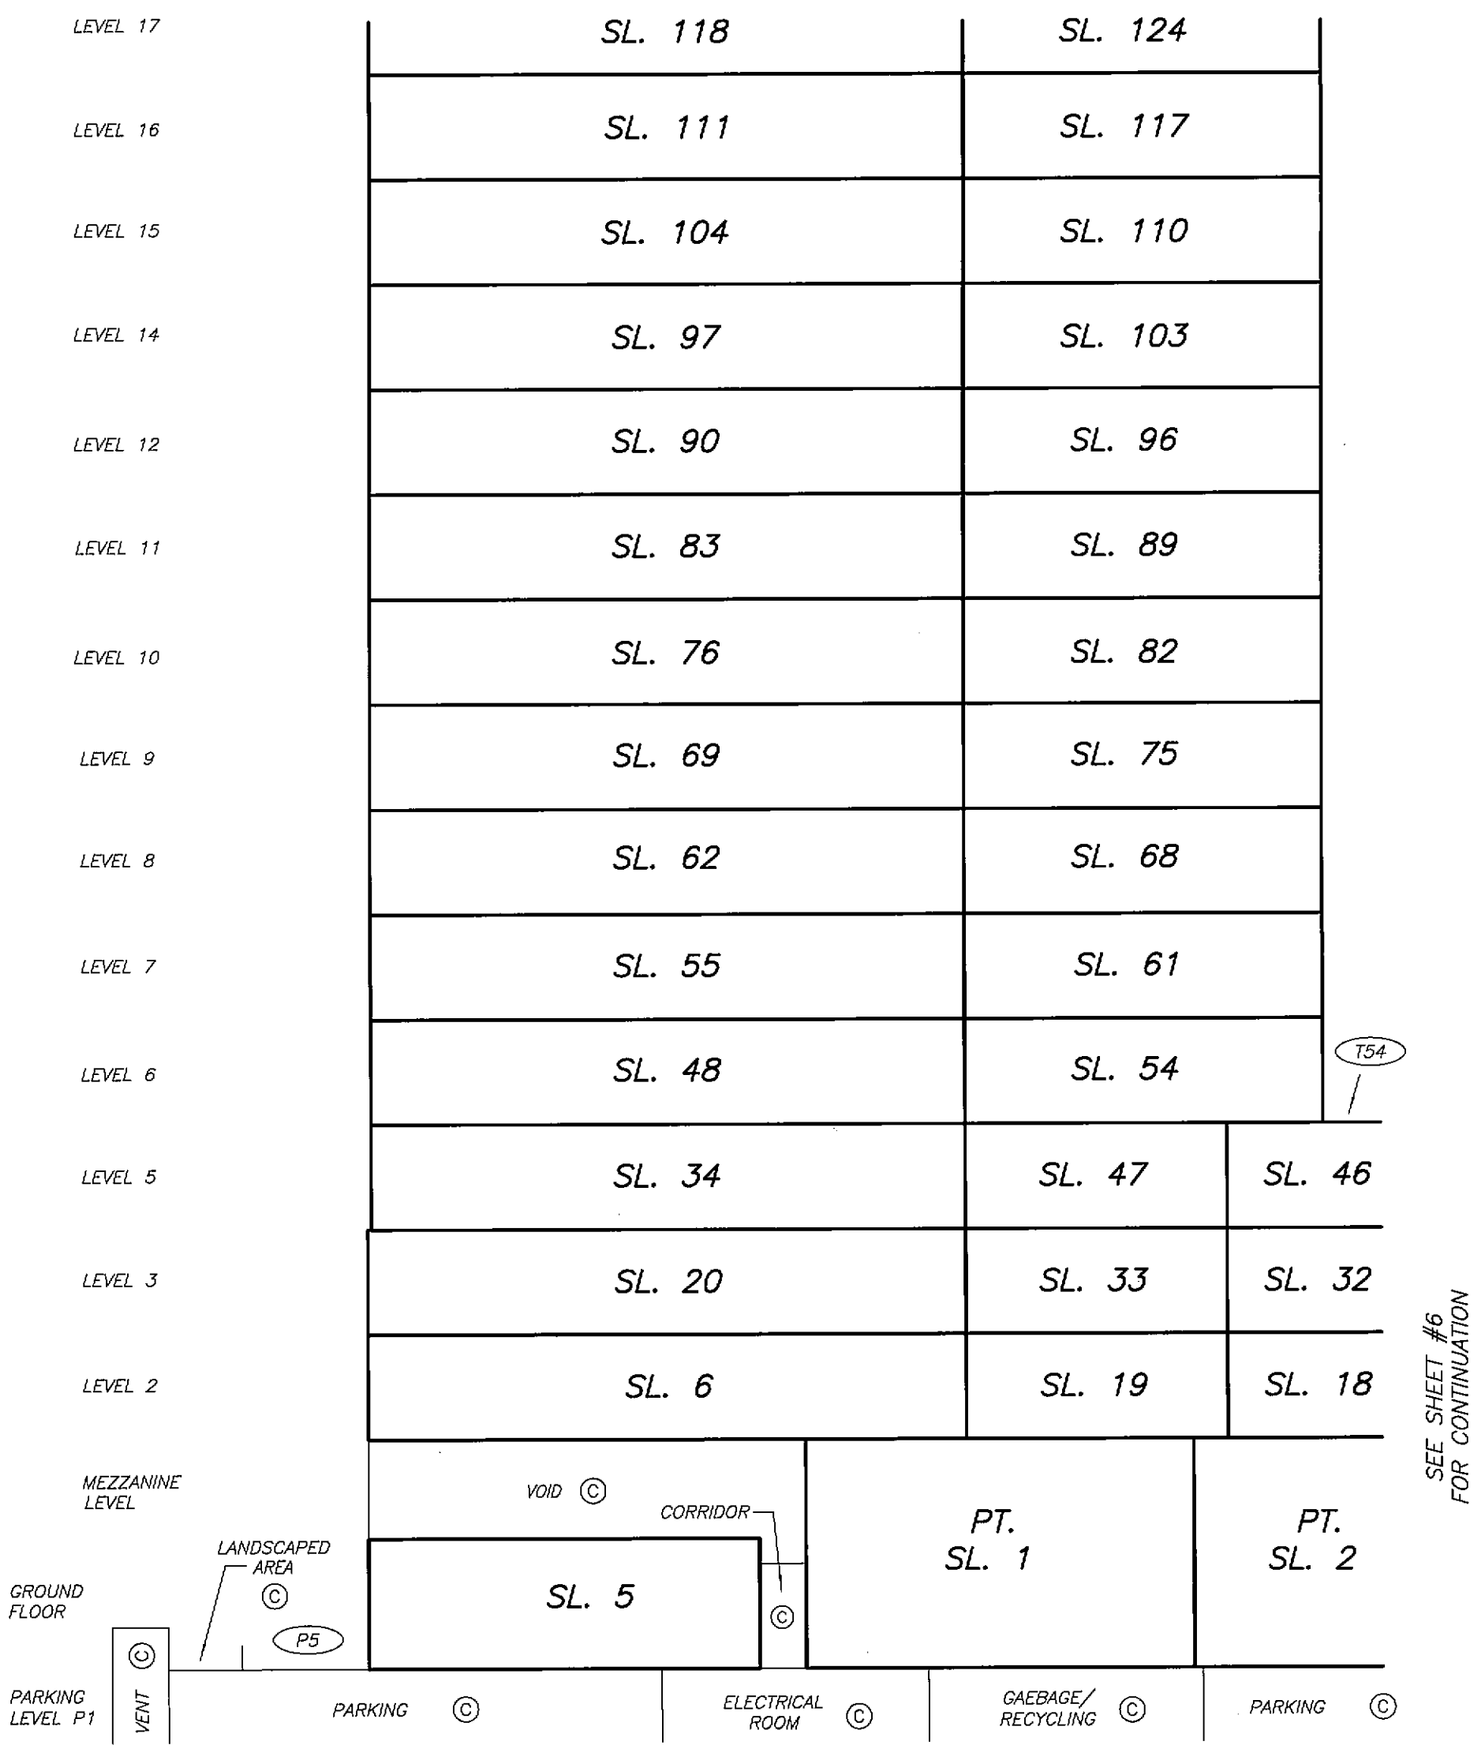

SEE SHEET #6
FOR CONTINUATION

SEE SHEET #5
FOR CONTINUATION

DATE : FEBRUARY 20, 2008

M.E.B.

DRAWING # 30624-10
FILE # 30624-10_Ss

ORIGINAL

FILED NMBCS2855 RCVD:2008-04-16 RQST:2010-03-09-14.00.13.395

SECTION A – A'

STRATA PLAN BCS 2855

SCALE 1:150

2 0 2 4 6

ALL DISTANCES ARE IN METRES.

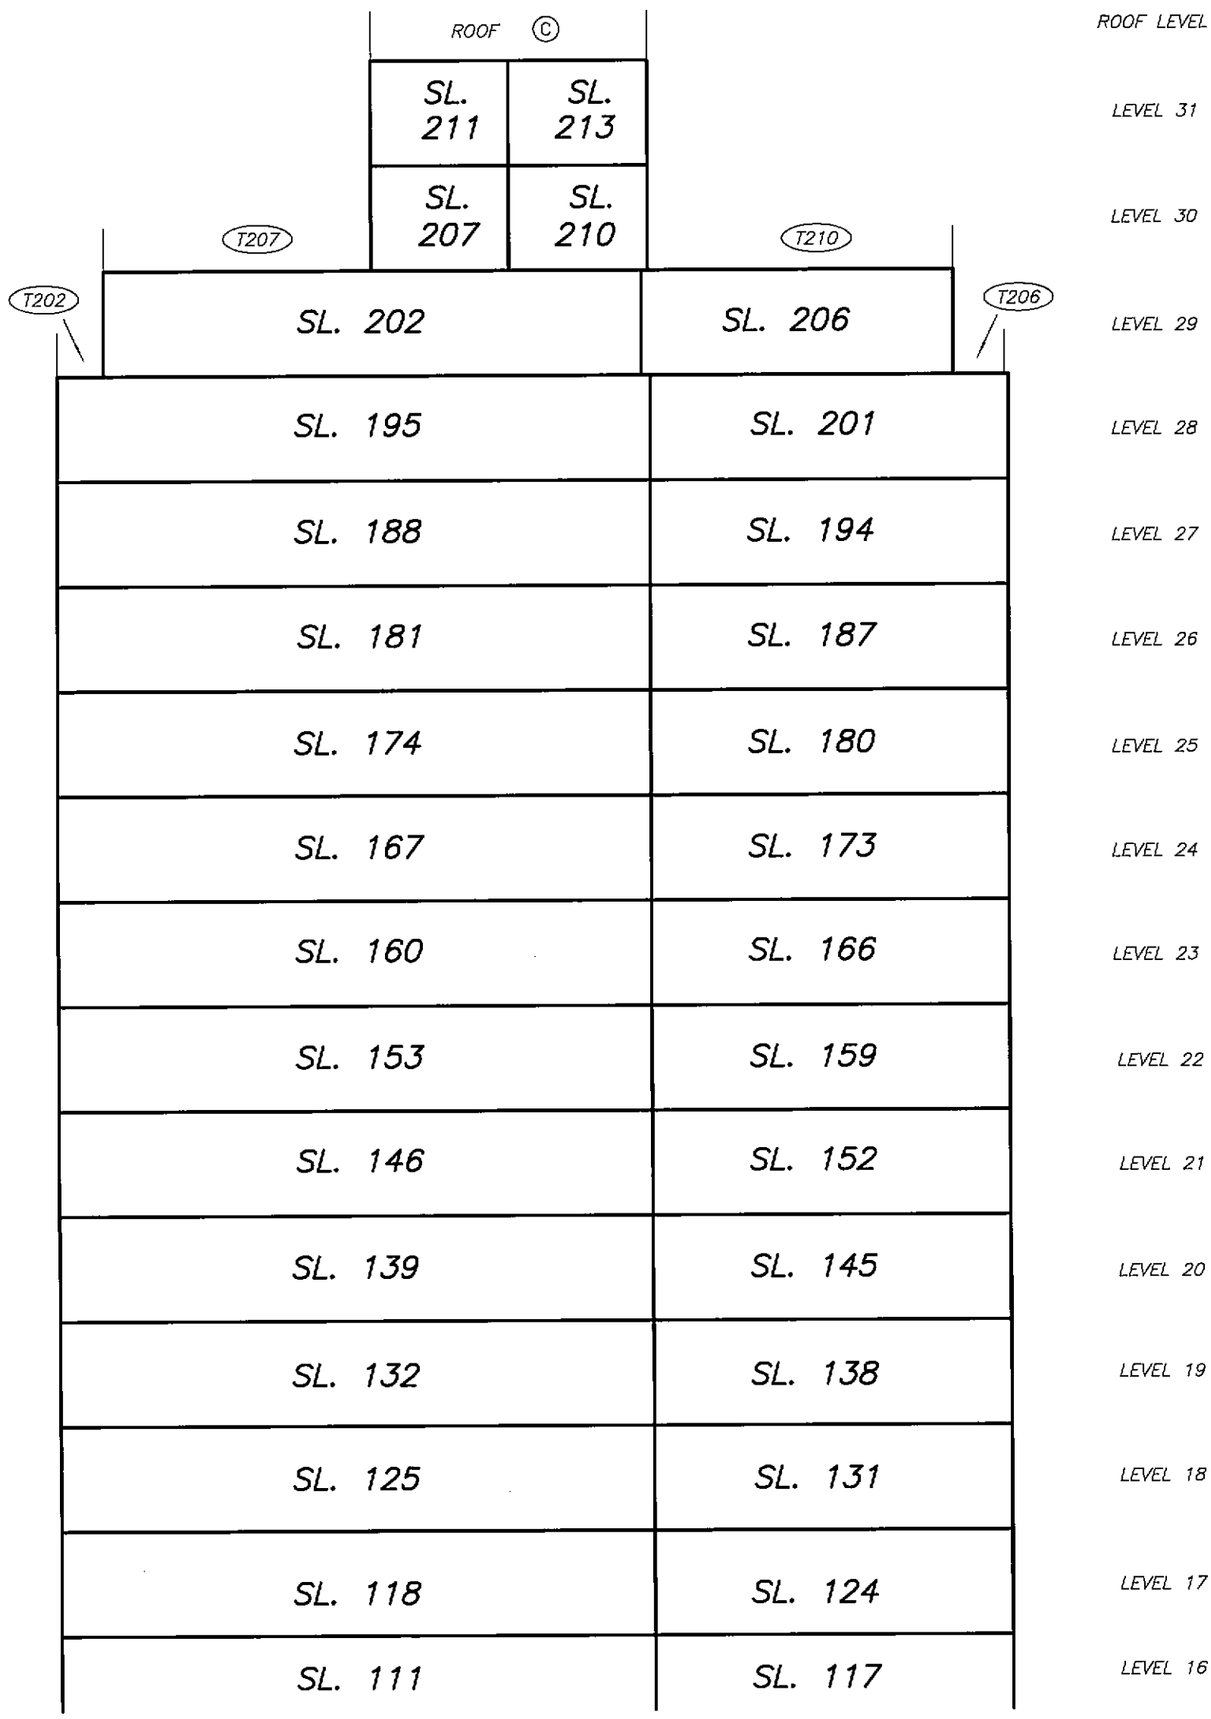

SEE SHEET #7
FOR CONTINUATION

DATE : FEBRUARY 20, 2008

M.E.S.

DRAWING # 30624-10
FILE # 30624-10_Sa

ORIGINAL

FILED NWBCS2855 RCVD:2008-04-16 RQST:2010-03-09-14.00.13.395

PARKING LEVEL P4

STRATA PLAN BCS 2855

SCALE 1:250

4 0 4 8

ALL DISTANCES ARE IN METRES.

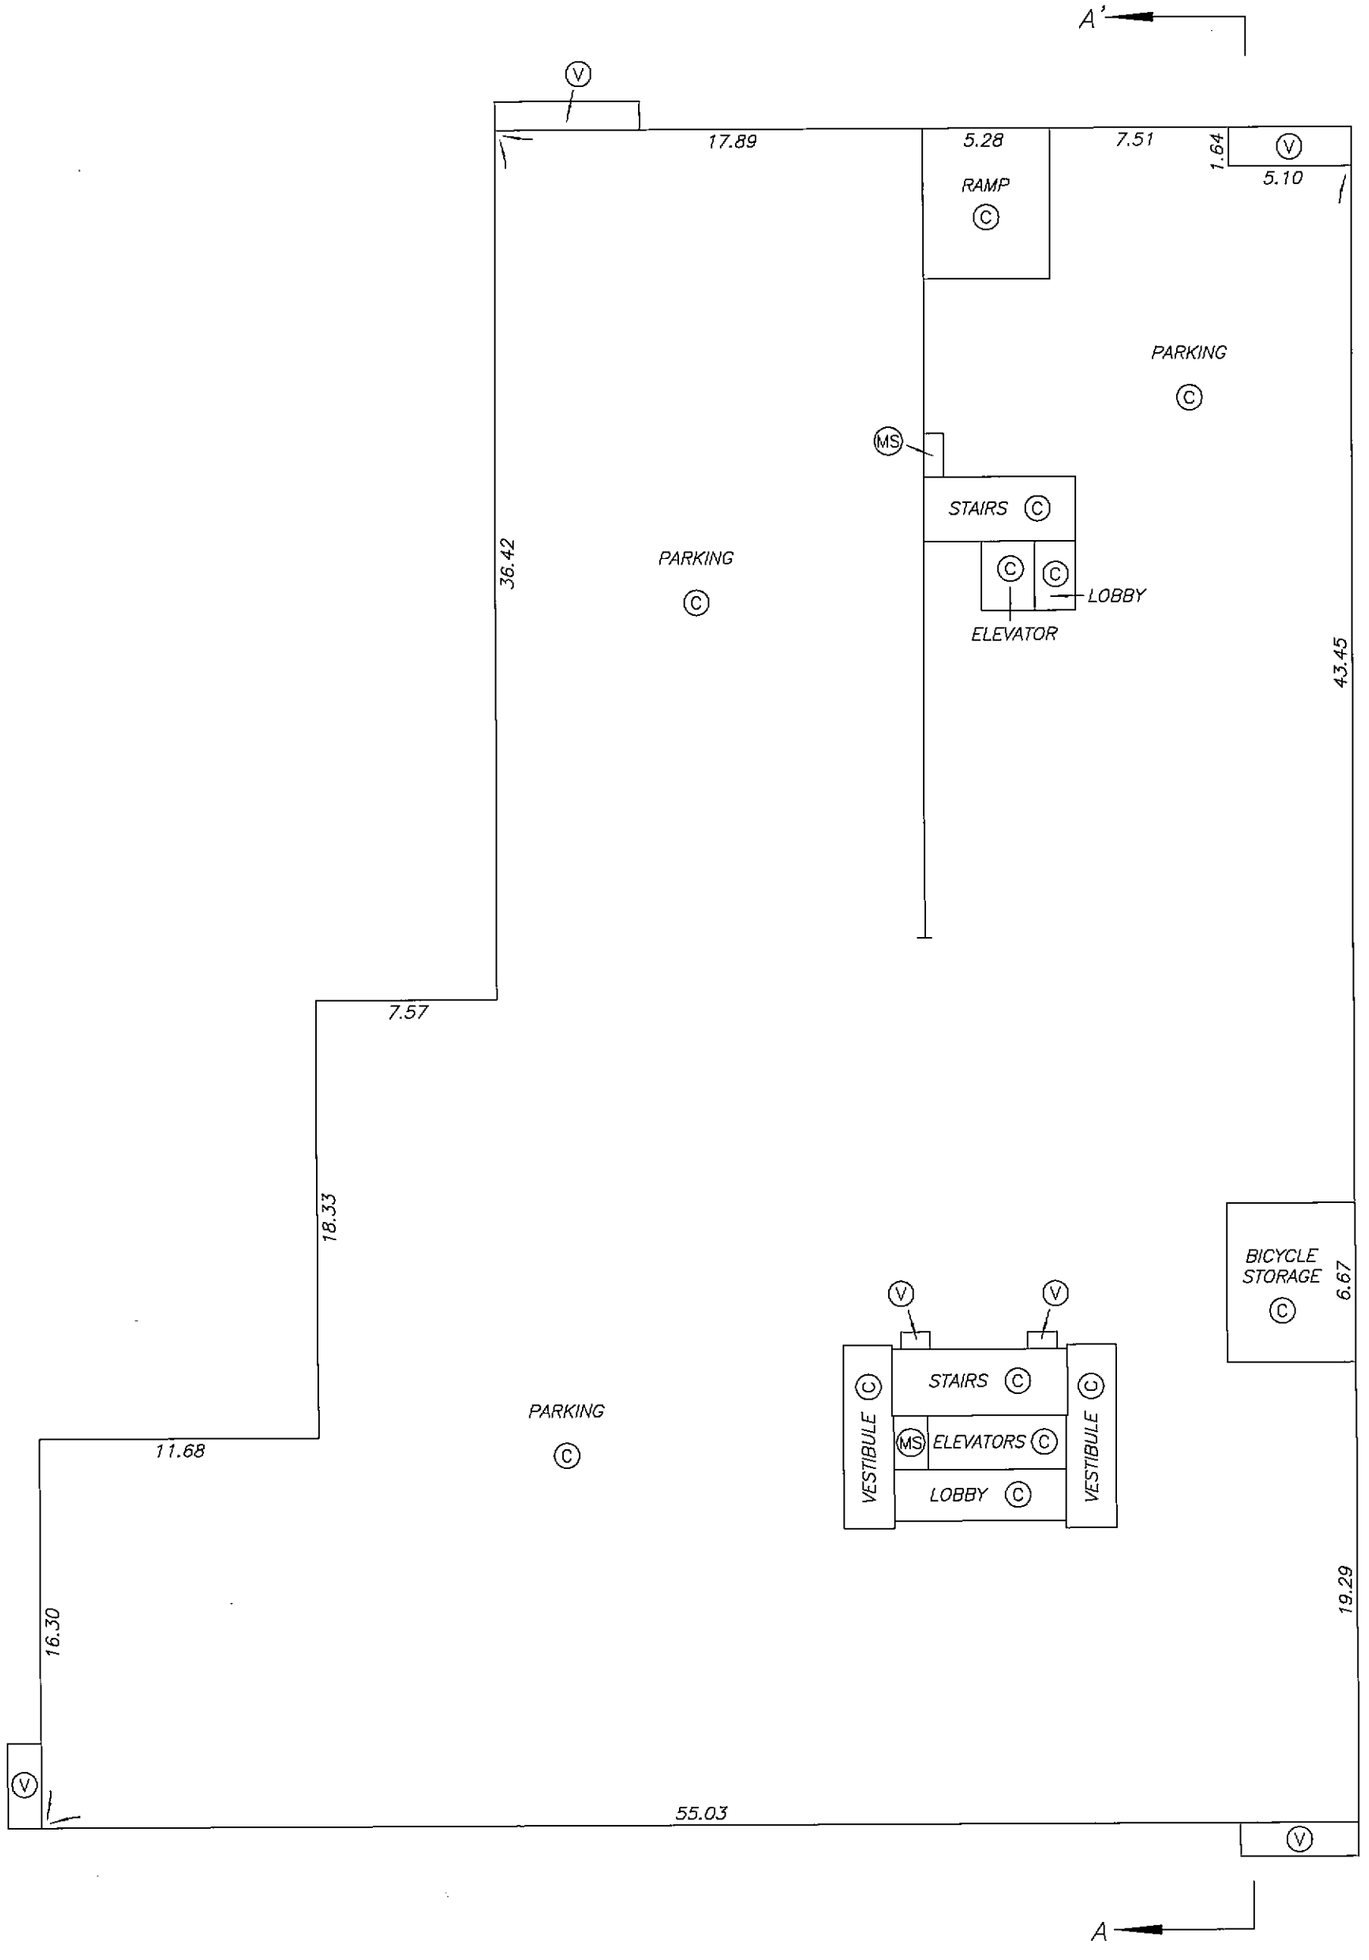

DATE : FEBRUARY 20, 2008

M.E.B.

DRAWING # 30624-10
FILE # 30624-10_P4

ORIGINAL

FILED NMBCS2855 RCVD:2008-04-16 RQST:2010-03-09-14.00.13.395

PARKING LEVEL P3

STRATA PLAN BCS 2855

SCALE 1:250

4 0 4 8

ALL DISTANCES ARE IN METRES.

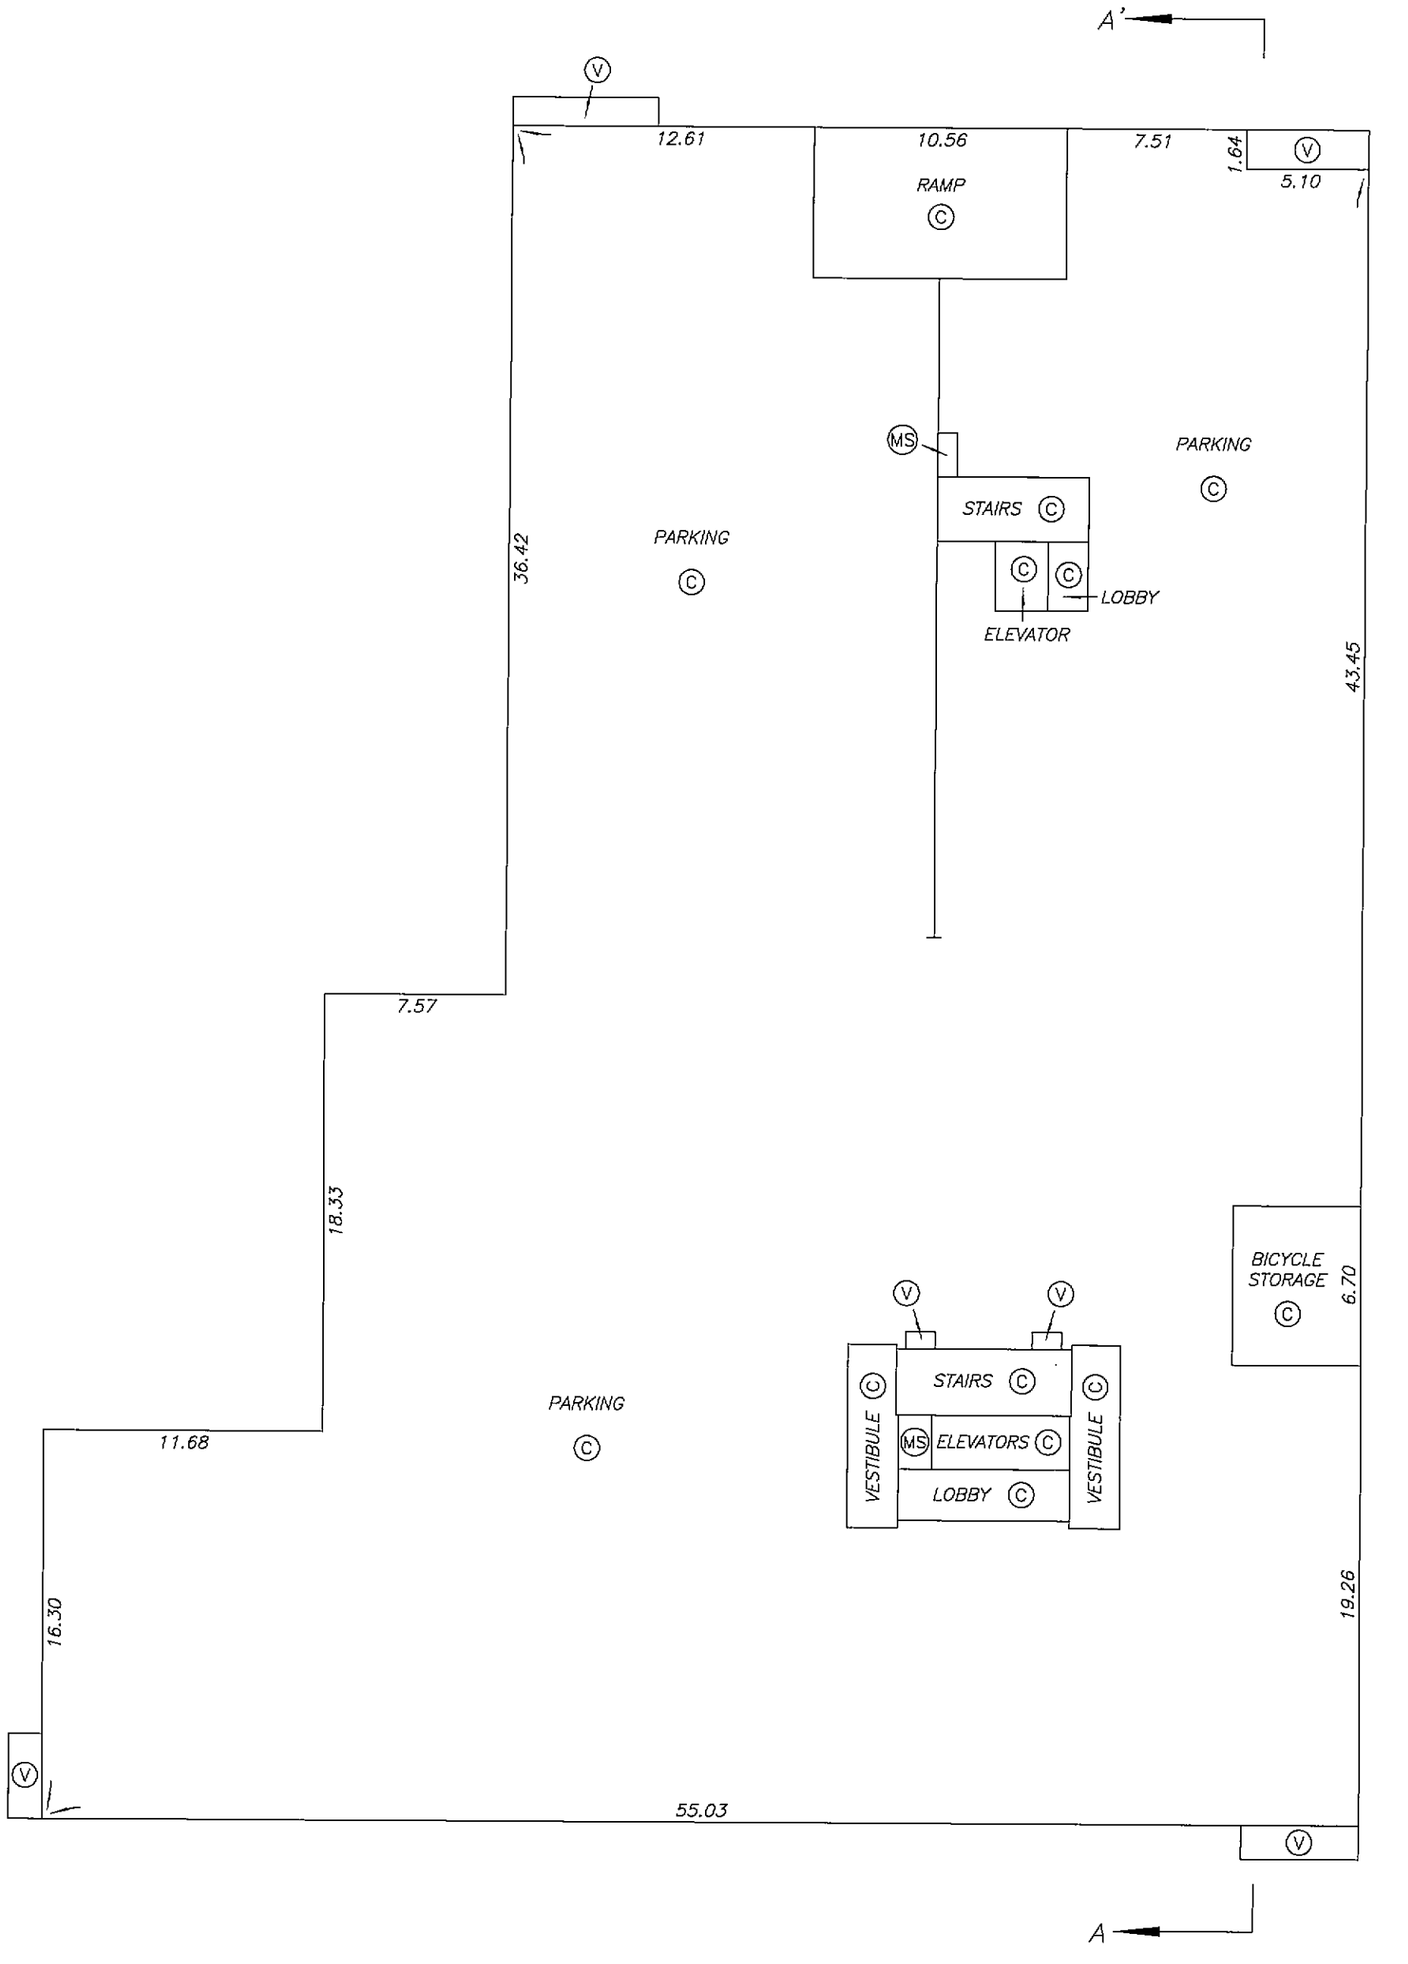

DATE : FEBRUARY 20, 2008

M.E.B.

DRAWING # 30624-10
FILE # 30624-10_P3

ORIGINAL

FILED NMBCS2855 RCVD:2008-04-16 RQST:2010-03-09-14.00.13.395

PARKING LEVEL P2

STRATA PLAN BCS 2855

SCALE 1:250

4 0 4 8

ALL DISTANCES ARE IN METRES.

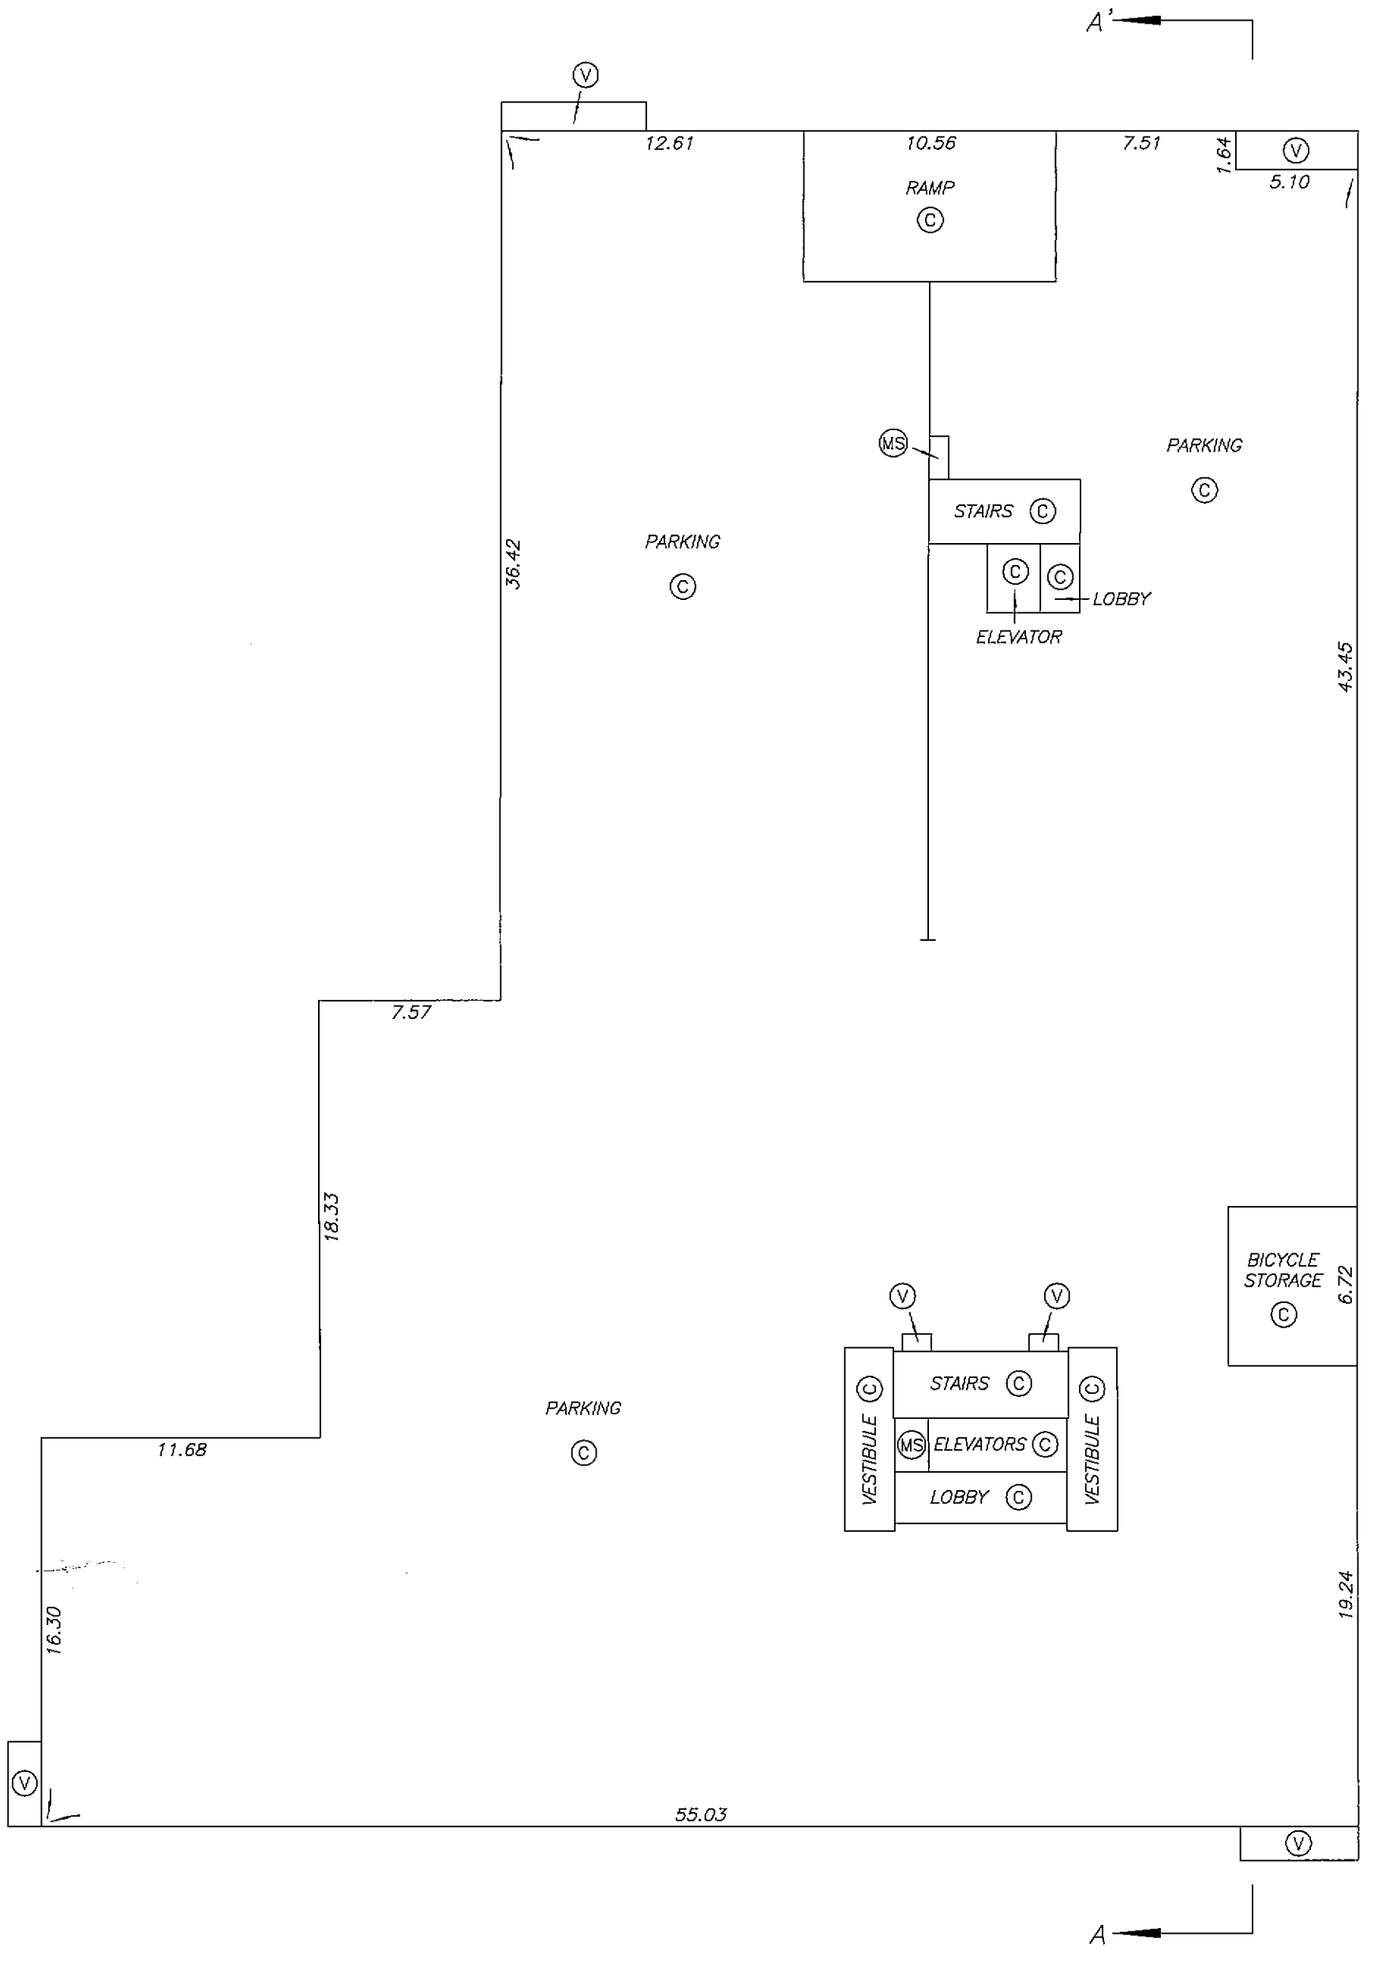

DATE : FEBRUARY 20, 2008

M.E.B.

DRAWING # 30624-10
FILE # 30624-10_P2

ORIGINAL

FILED NMBCS2855 RCVD:2008-04-16 RQST:2010-03-09-14.00.13.395

PARKING LEVEL P1

STRATA PLAN BCS 2855

SCALE 1:250

4 0 4 8

ALL DISTANCES ARE IN METRES.

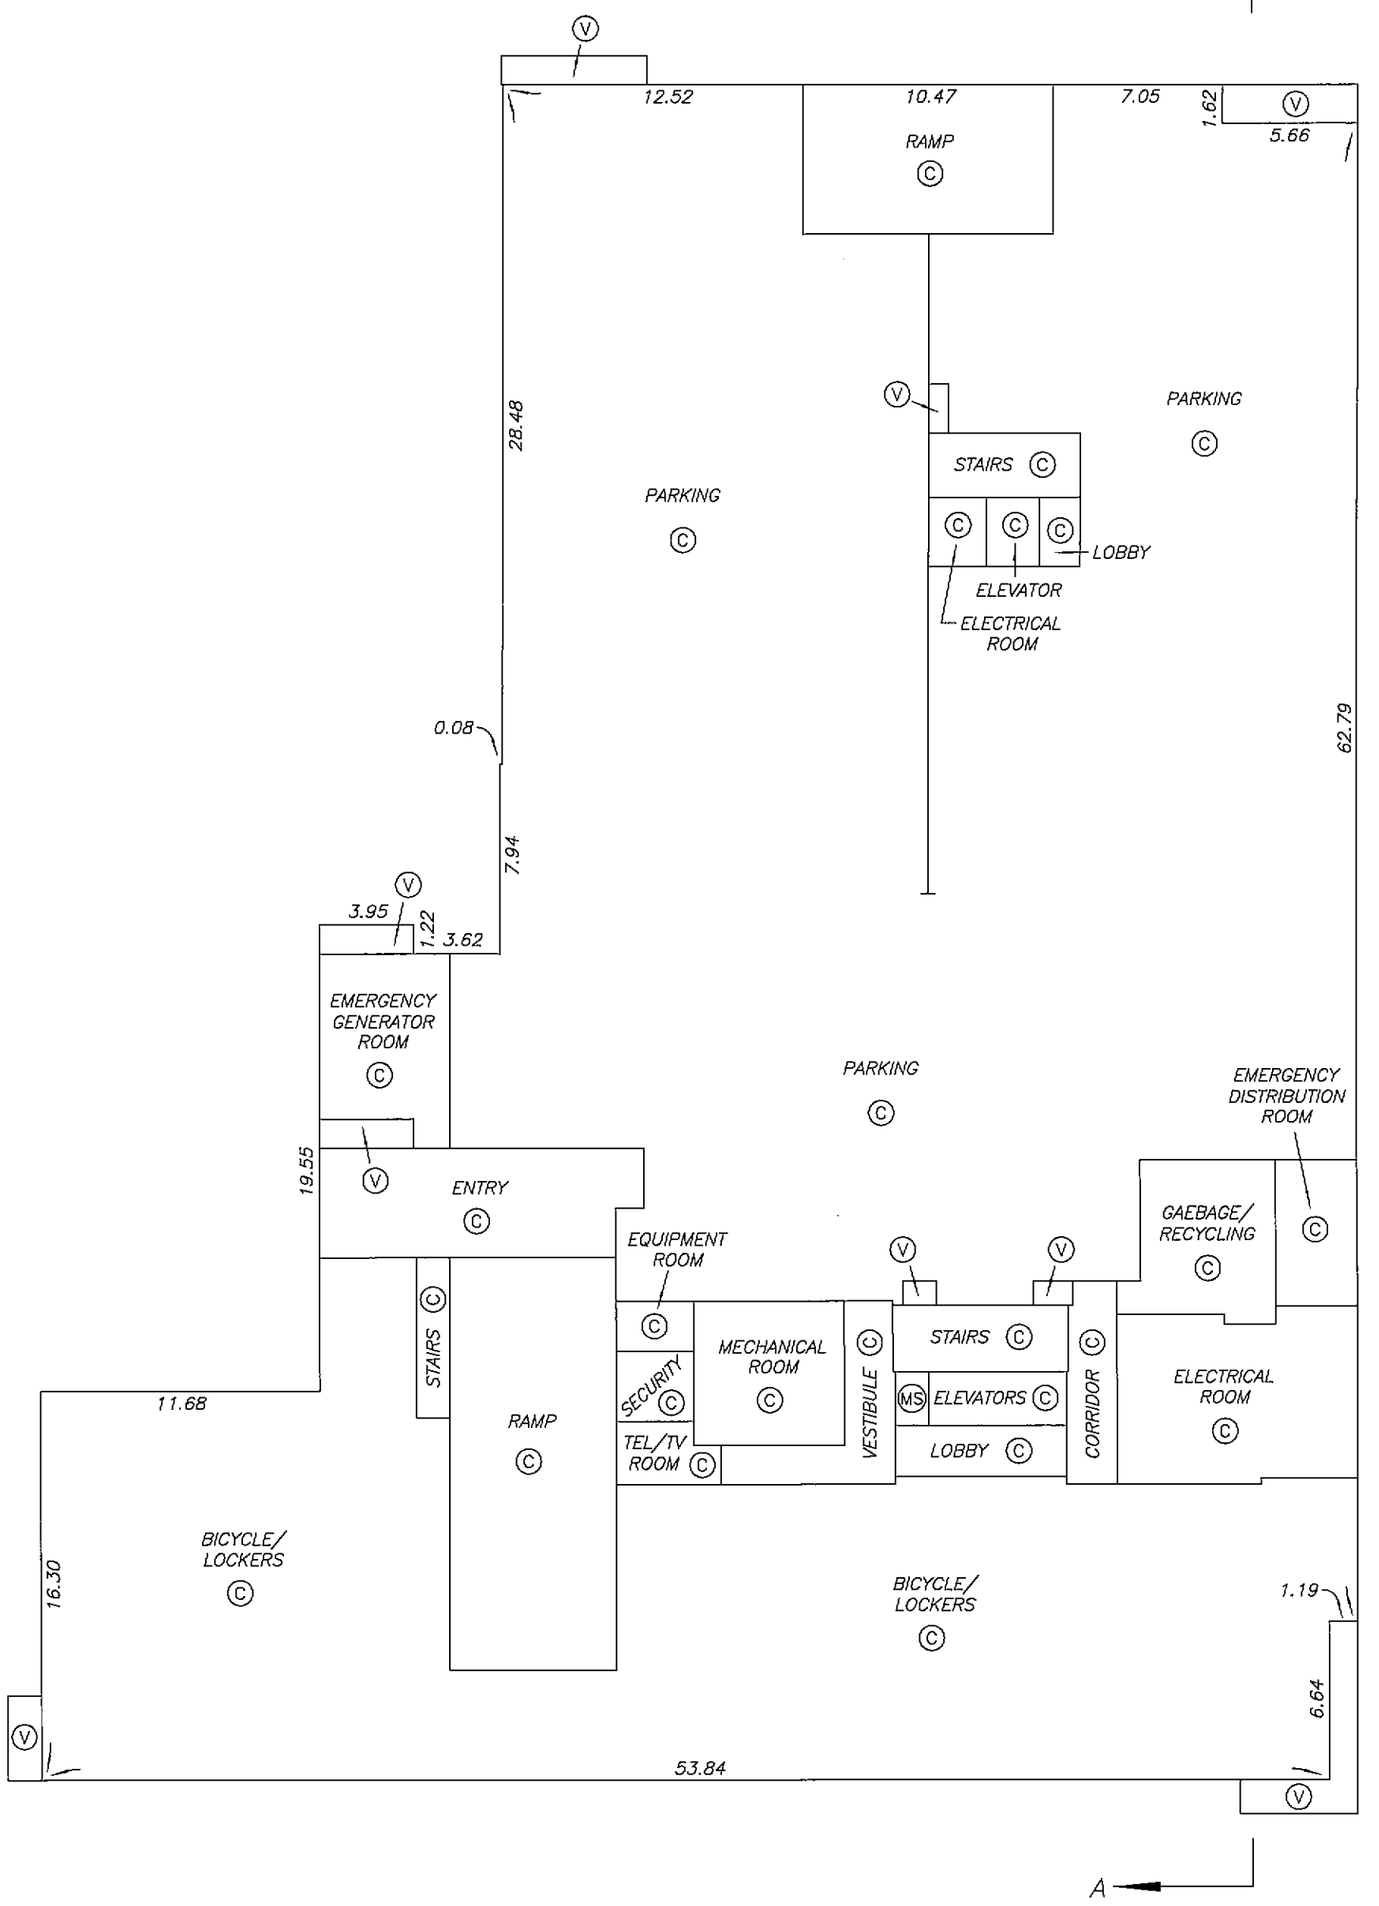

DATE : FEBRUARY 20, 2008

M.E.S.

DRAWING # 30624-10
FILE # 30624-10_P1

ORIGINAL

FILED NMBCS2855 RCVD:2008-04-16 RQST:2010-03-09-14.00.13.395

GROUND FLOOR PLAN
WEST PORTION

STRATA PLAN BCS 2855

SCALE 1:150

2 0 2 4 6

ALL DISTANCES ARE IN METRES.

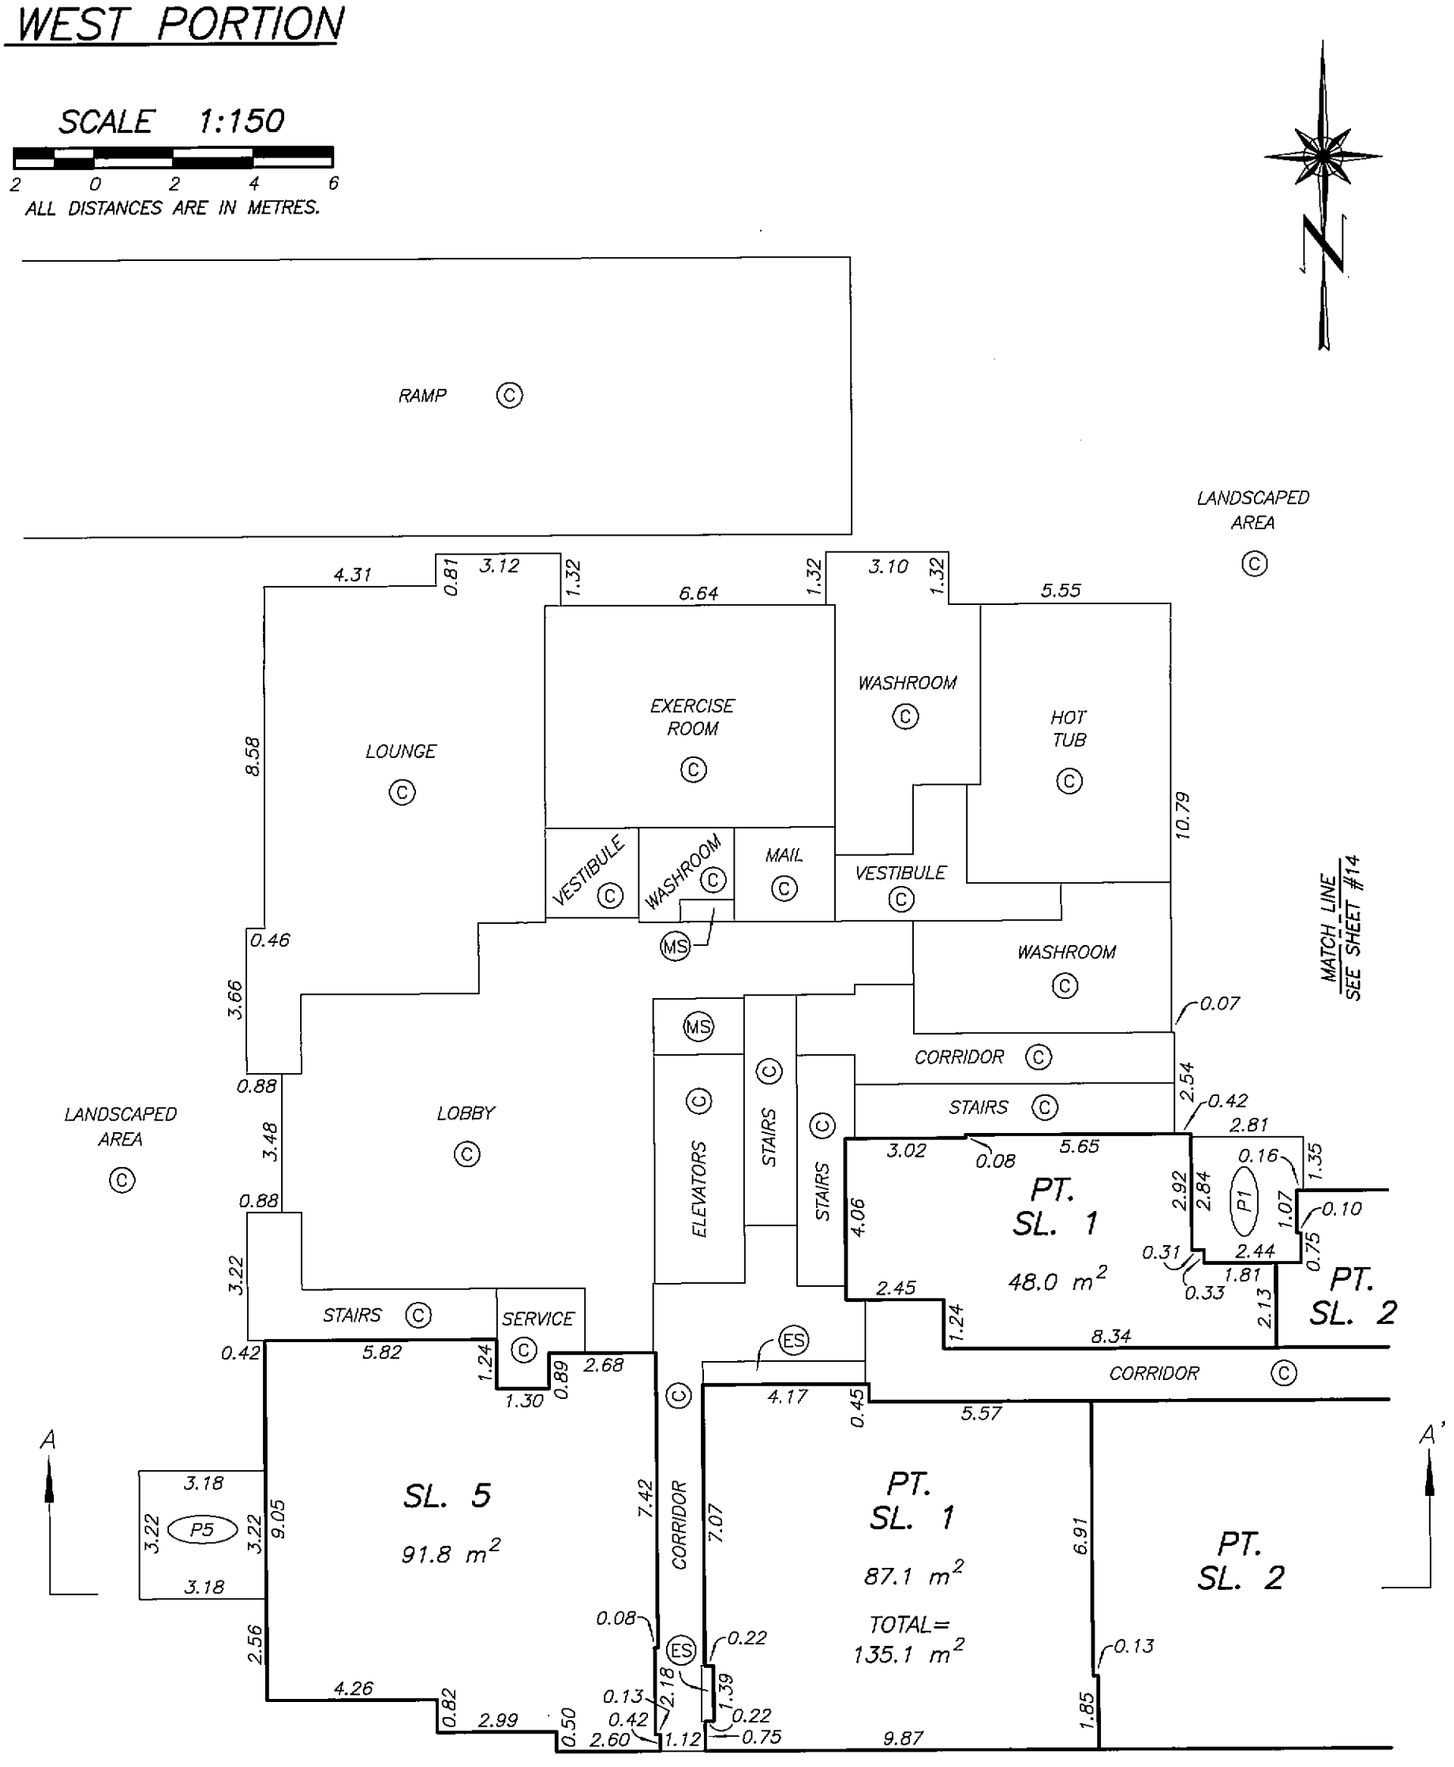

DATE : FEBRUARY 20, 2008

M.E.S.

DRAWING # 30624-10
FILE # 30624-10_L1

ORIGINAL

FILED NWBCS2855 RCVD:2008-04-16 RQST:2010-03-09-14.00.13.395

GROUND FLOOR PLAN
EAST PORTION

STRATA PLAN BCS 2855

SCALE 1:150

2 0 2 4 6

ALL DISTANCES ARE IN METRES.

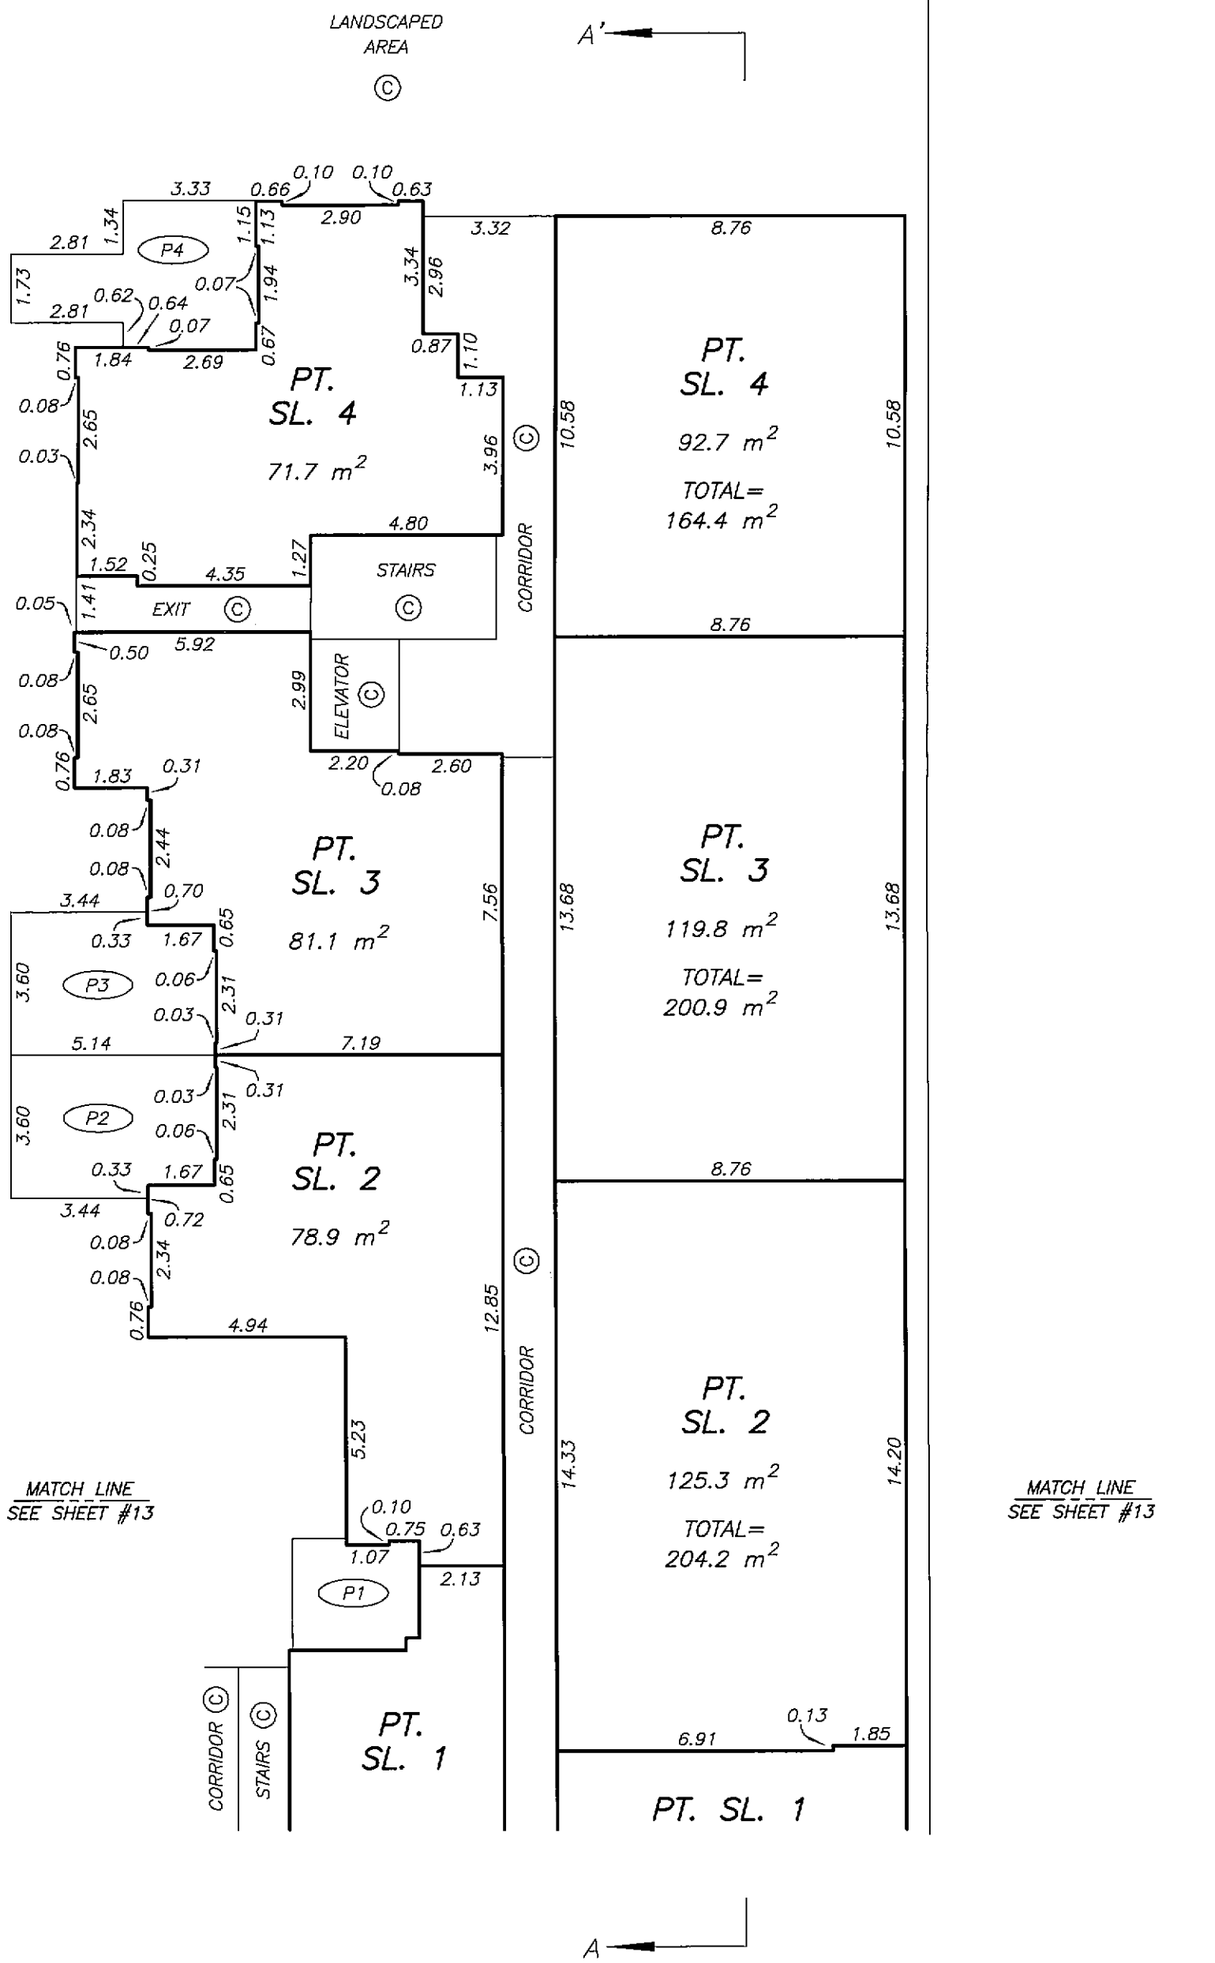

DATE : FEBRUARY 20, 2008

M.E.S.

DRAWING # 30624-10
FILE # 30624-10_L2

ORIGINAL

FILED NMBCS2855 RCVD:2008-04-16 RQST:2010-03-09-14.00.13.395

MEZZANINE LEVEL FLOOR PLAN WEST PORTION

STRATA PLAN BCS 2855

SCALE 1:150

2 0 2 4 6

ALL DISTANCES ARE IN METRES.

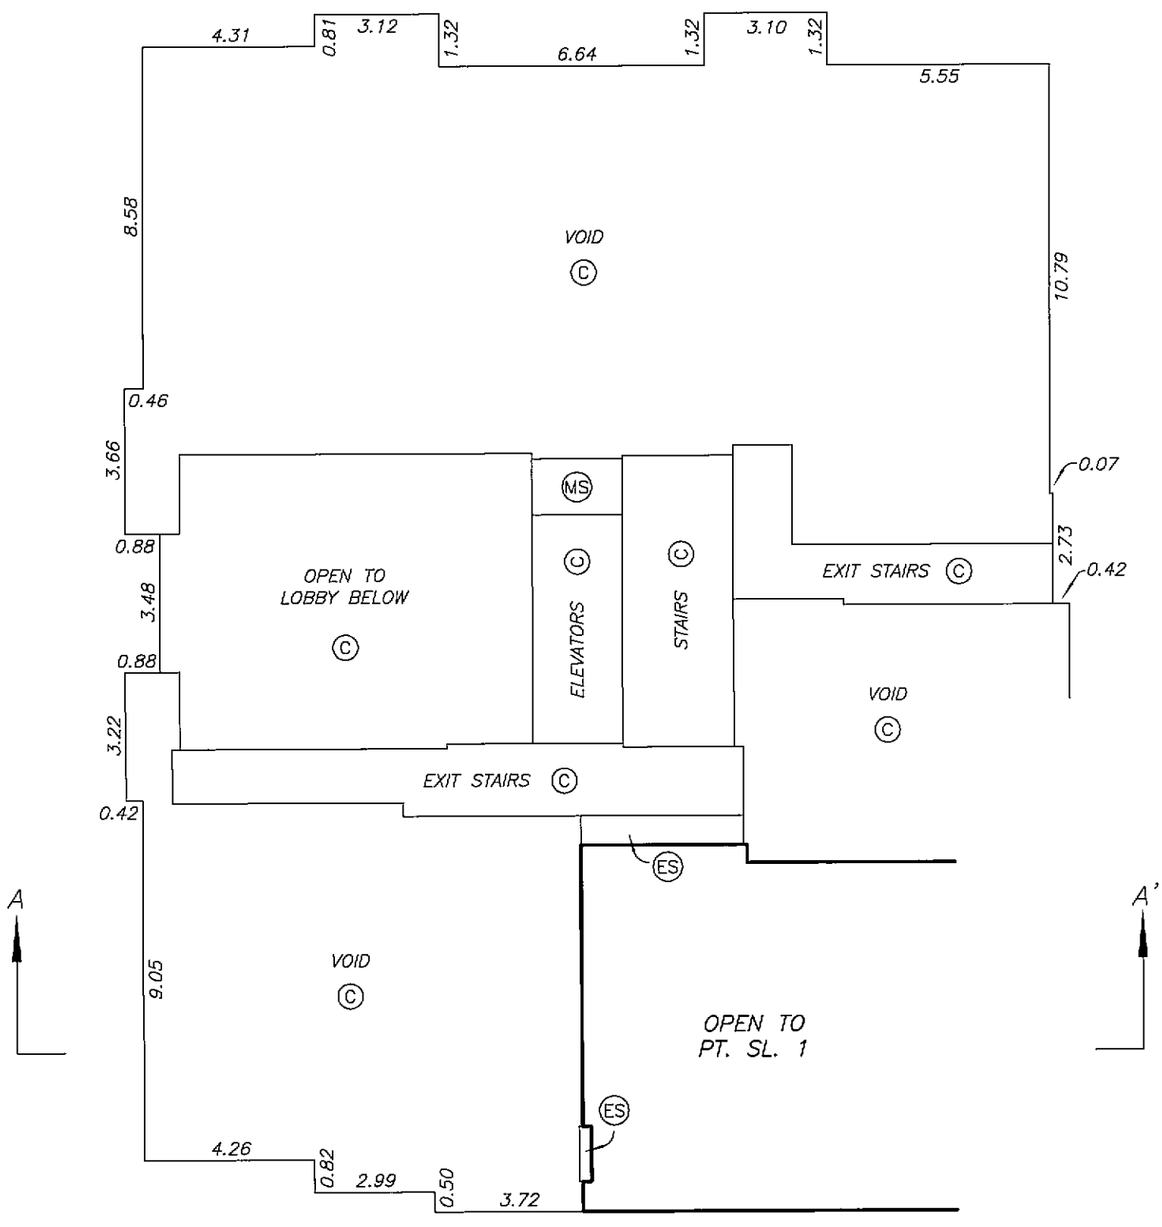

DATE : FEBRUARY 20, 2008

M.E.S.

DRAWING # 30624-10
FILE # 30624-10_L1-Mezz

ORIGINAL

FILED NWBCS2855 RCVD:2008-04-16 RQST:2010-03-09-14.00.13.395

LEVEL 2 FLOOR PLAN WEST PORTION

STRATA PLAN BCS 2855

SCALE 1:150

2 0 2 4 6

ALL DISTANCES ARE IN METRES.

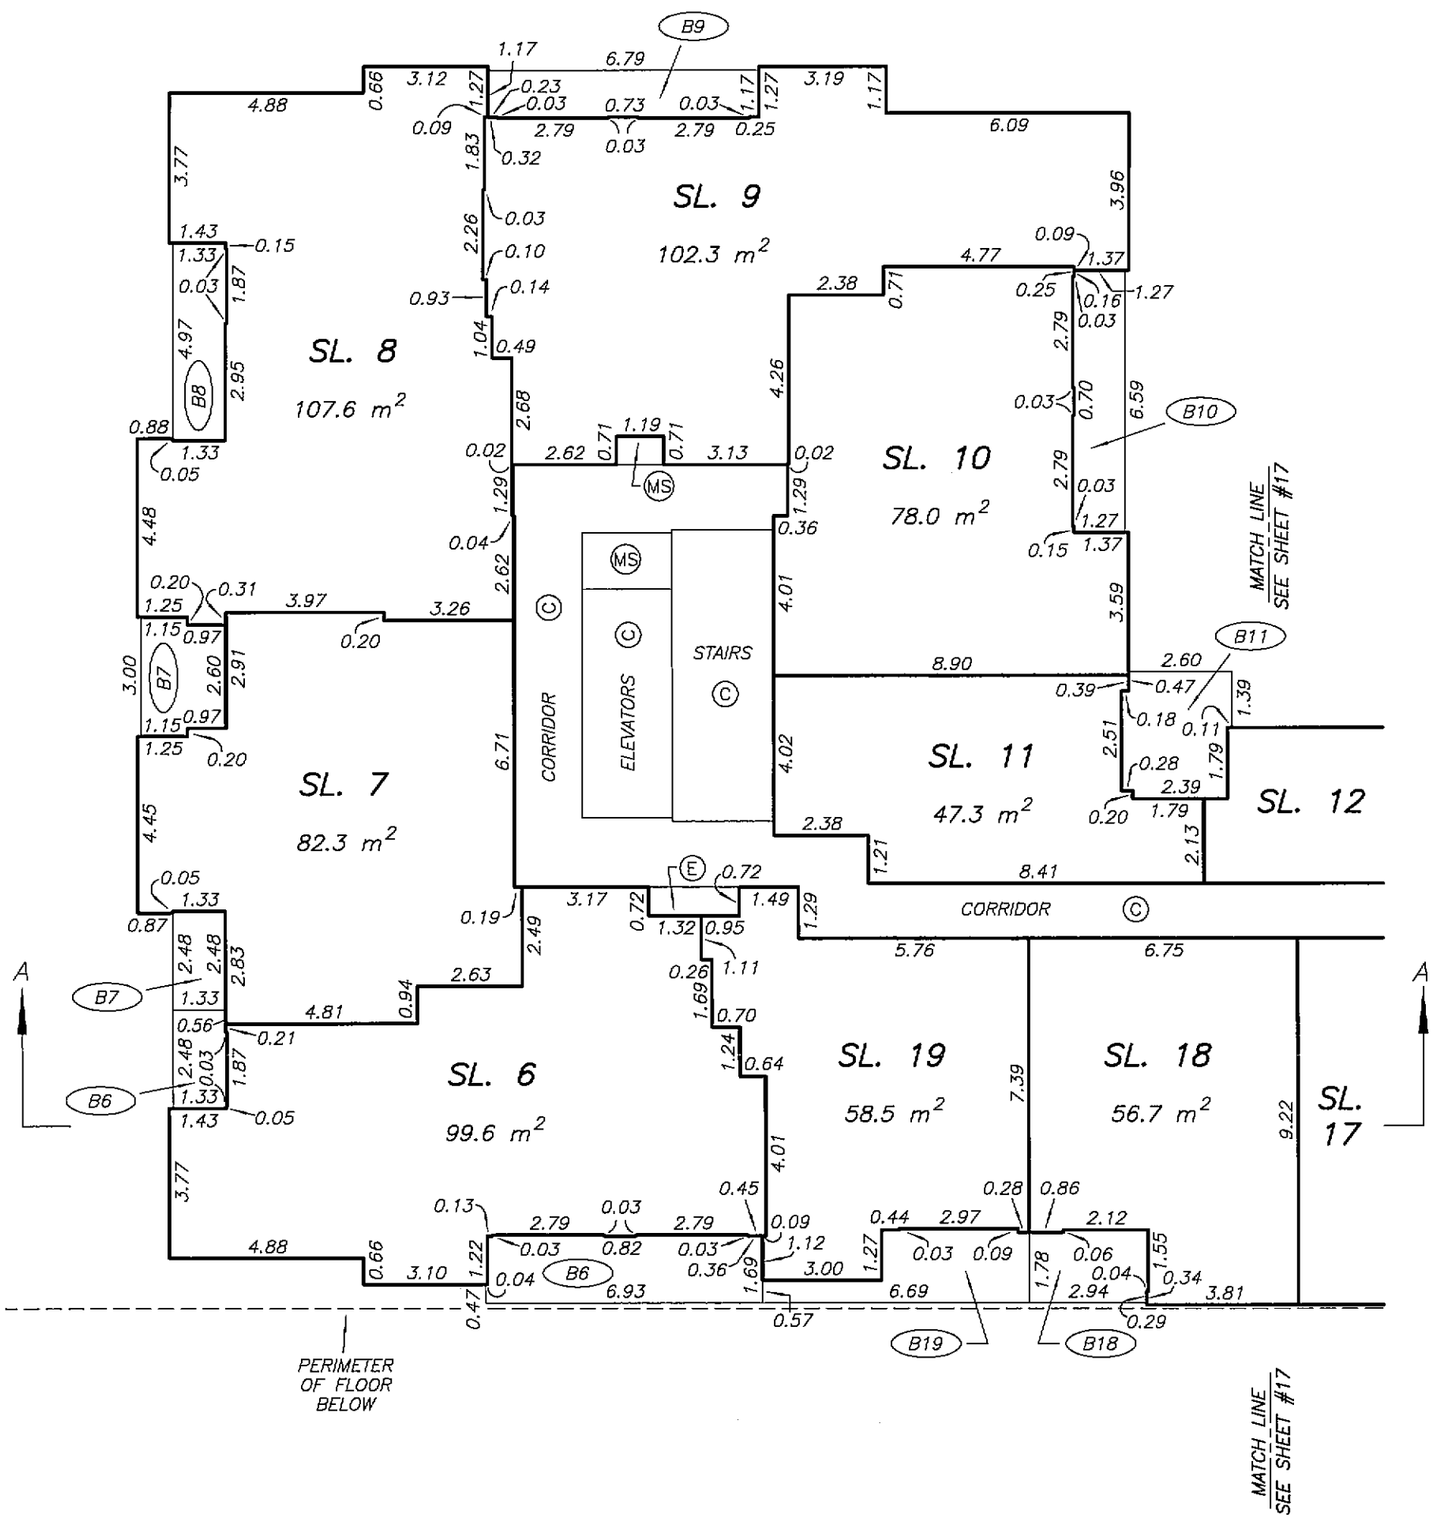

DATE : FEBRUARY 20, 2008

M.E.B.

DRAWING # 30624-10
FILE # 30624-10_L2

ORIGINAL

FILED NMBCS2855 RCVD:2008-04-16 RQST:2010-03-09-14.00.13.395

LEVEL 2 FLOOR PLAN EAST PORTION

STRATA PLAN BCS 2855

SCALE 1:150

2 0 2 4 6

ALL DISTANCES ARE IN METRES.

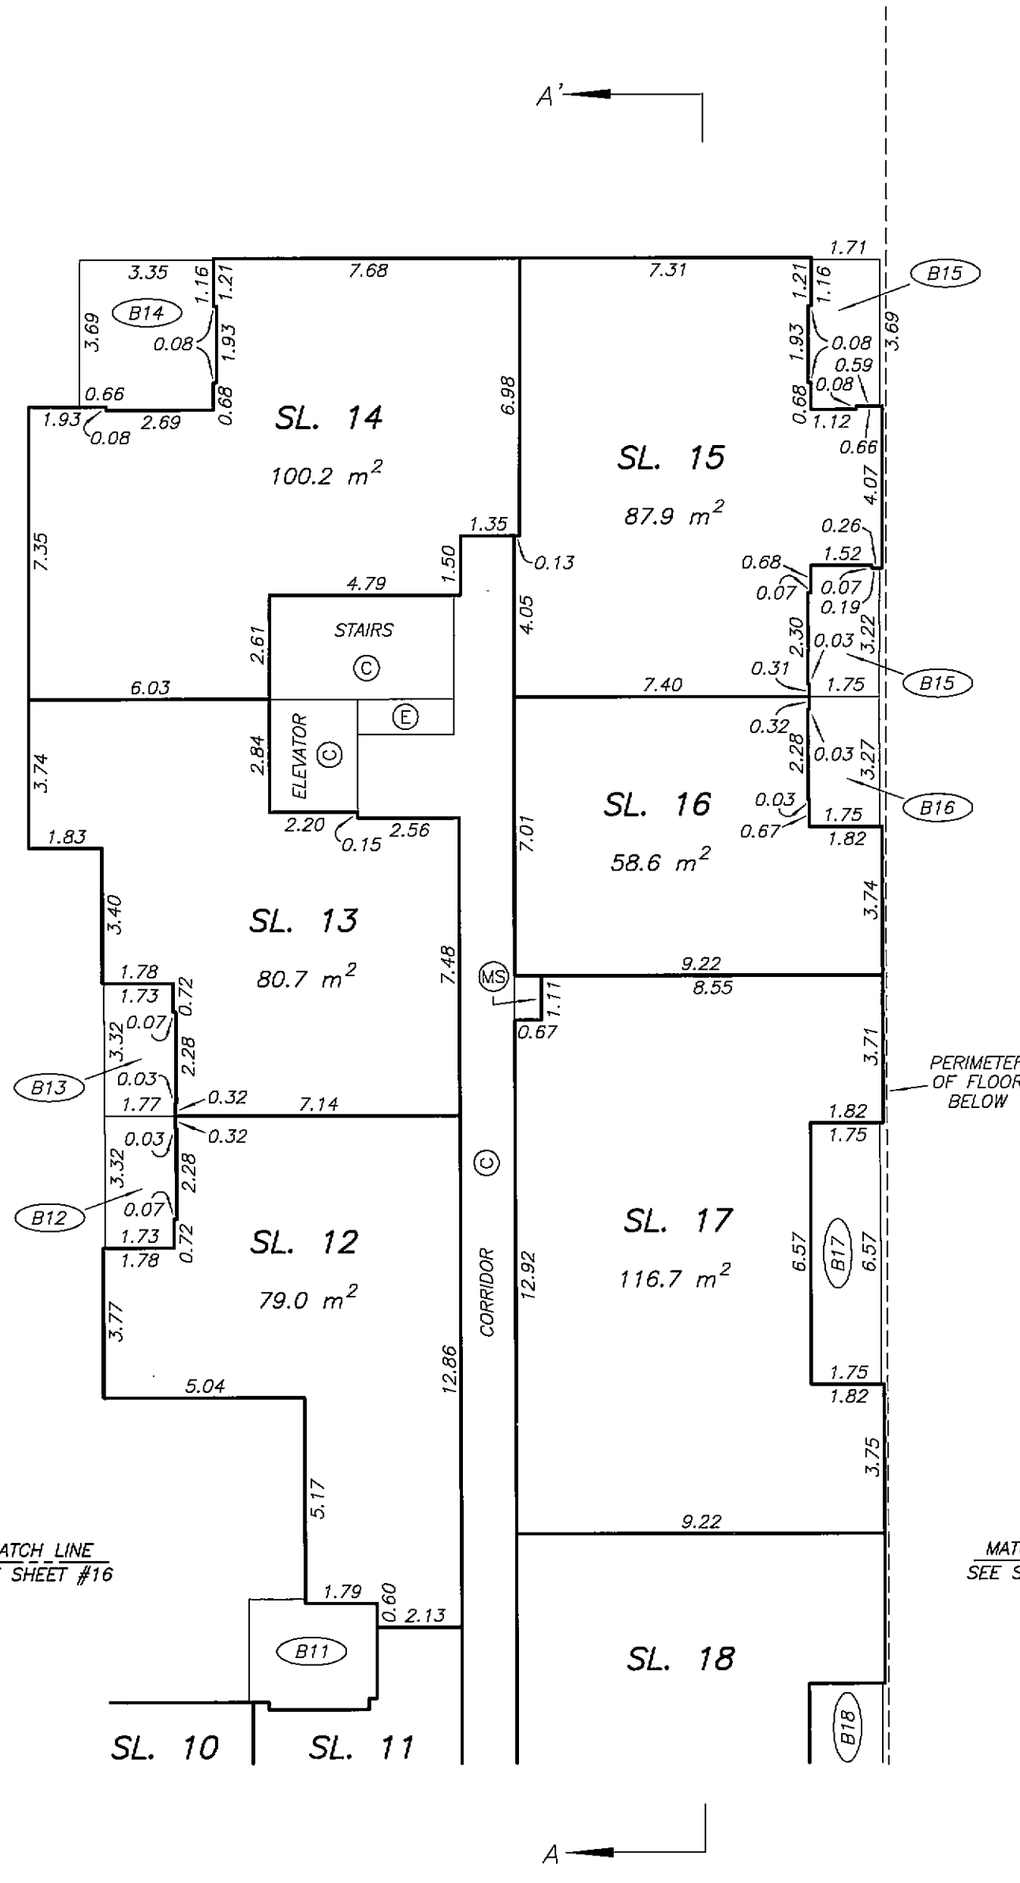

DATE : FEBRUARY 20, 2008

M.E.S.

DRAWING # 30624-10
FILE # 30624-10_L2

ORIGINAL

FILED NMBCS2855 RCVD:2008-04-16 RQST:2010-03-09-14.00.13.395

LEVEL 3 FLOOR PLAN WEST PORTION

STRATA PLAN BCS 2855

SCALE 1:150

2 0 2 4 6

ALL DISTANCES ARE IN METRES.

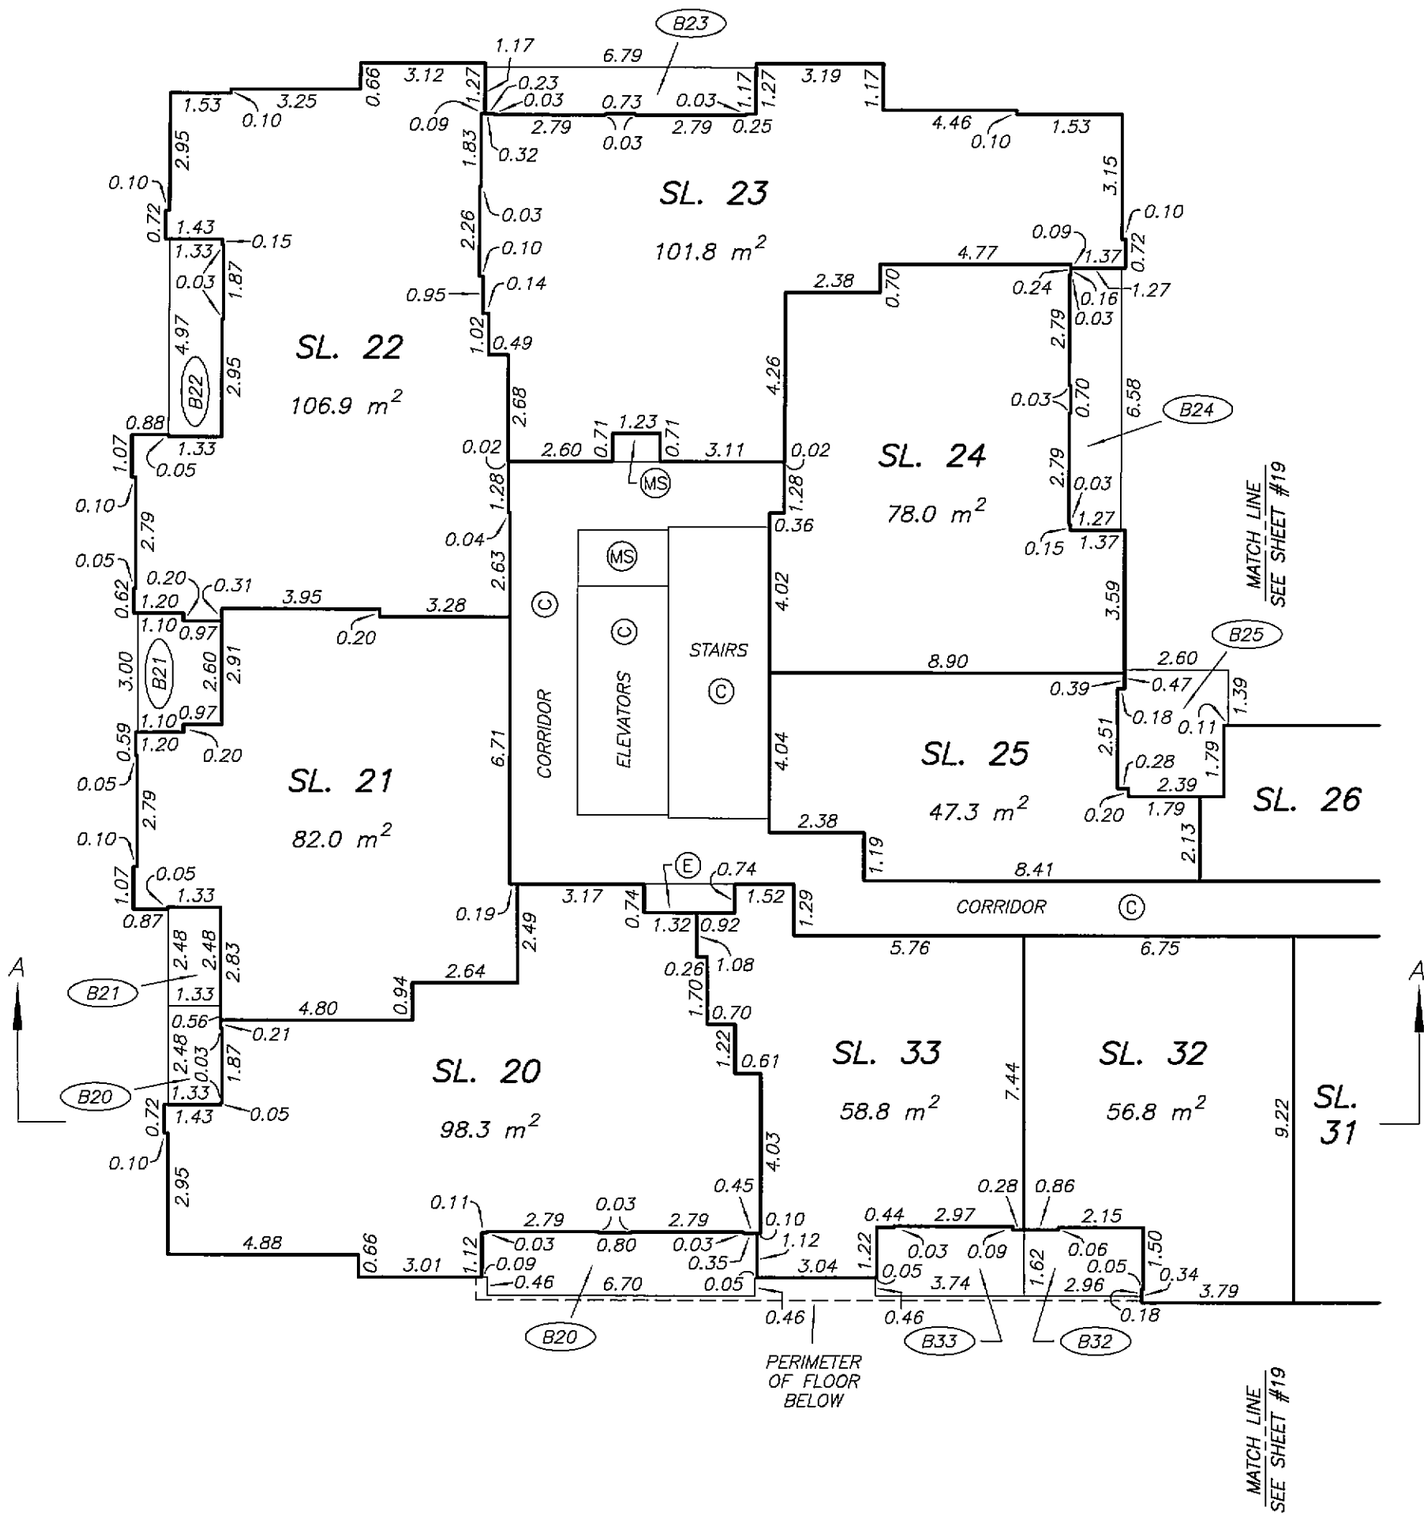

DATE : FEBRUARY 20, 2008

M.E.S.

DRAWING # 30624-10
FILE # 30624-10_L3

ORIGINAL

FILED NWBCS2855 RCVD:2008-04-16 RQST:2010-03-09-14.00.13.395

LEVEL 3 FLOOR PLAN EAST PORTION

STRATA PLAN BCS 2855

SCALE 1:150

2 0 2 4 6

ALL DISTANCES ARE IN METRES.

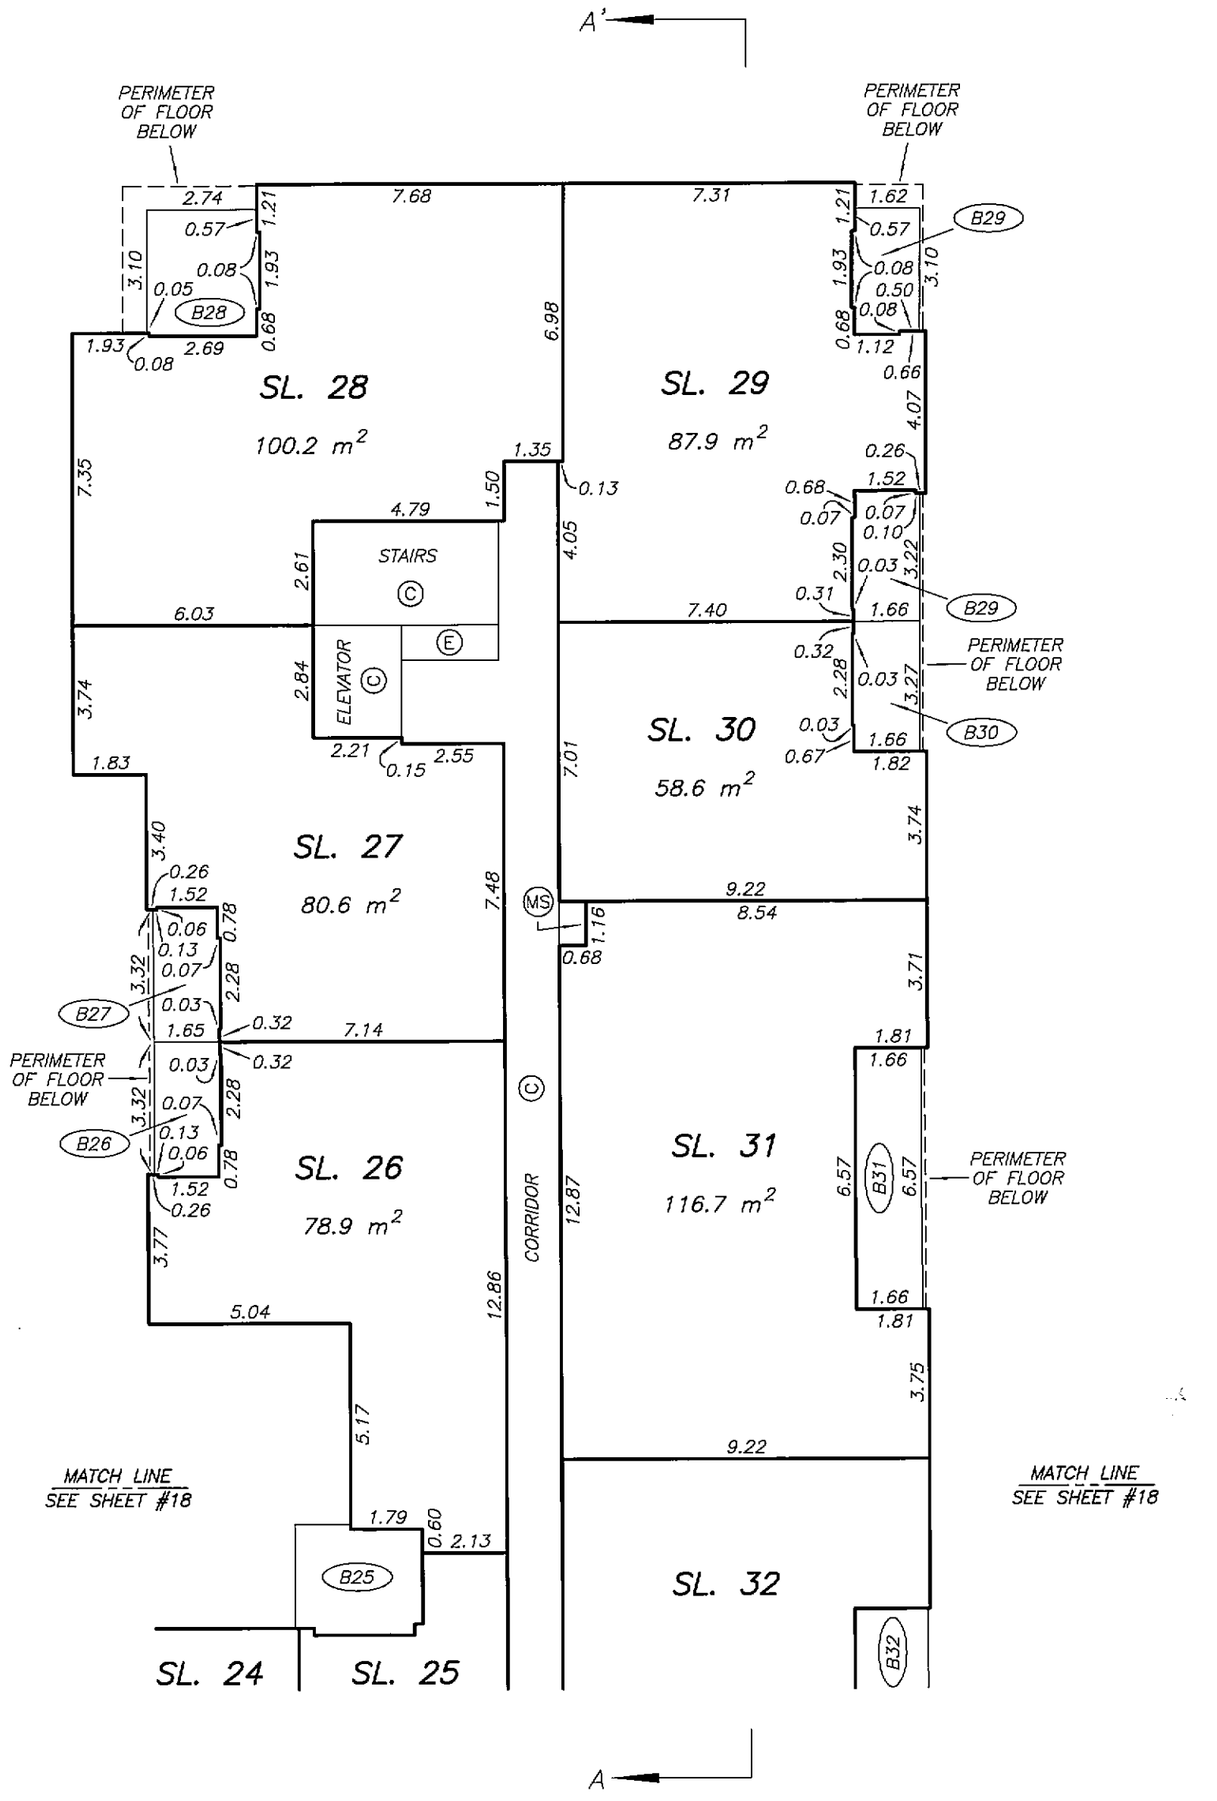

DATE : FEBRUARY 20, 2008

M.E.S.

DRAWING # 30624-10
FILE # 30624-10_L3

ORIGINAL

FILED NWBCS2855 RCVD:2008-04-16 RQST:2010-03-09-14.00.13.395

LEVEL 5 FLOOR PLAN WEST PORTION

STRATA PLAN BCS 2855

SCALE 1:150

2 0 2 4 6

ALL DISTANCES ARE IN METRES.

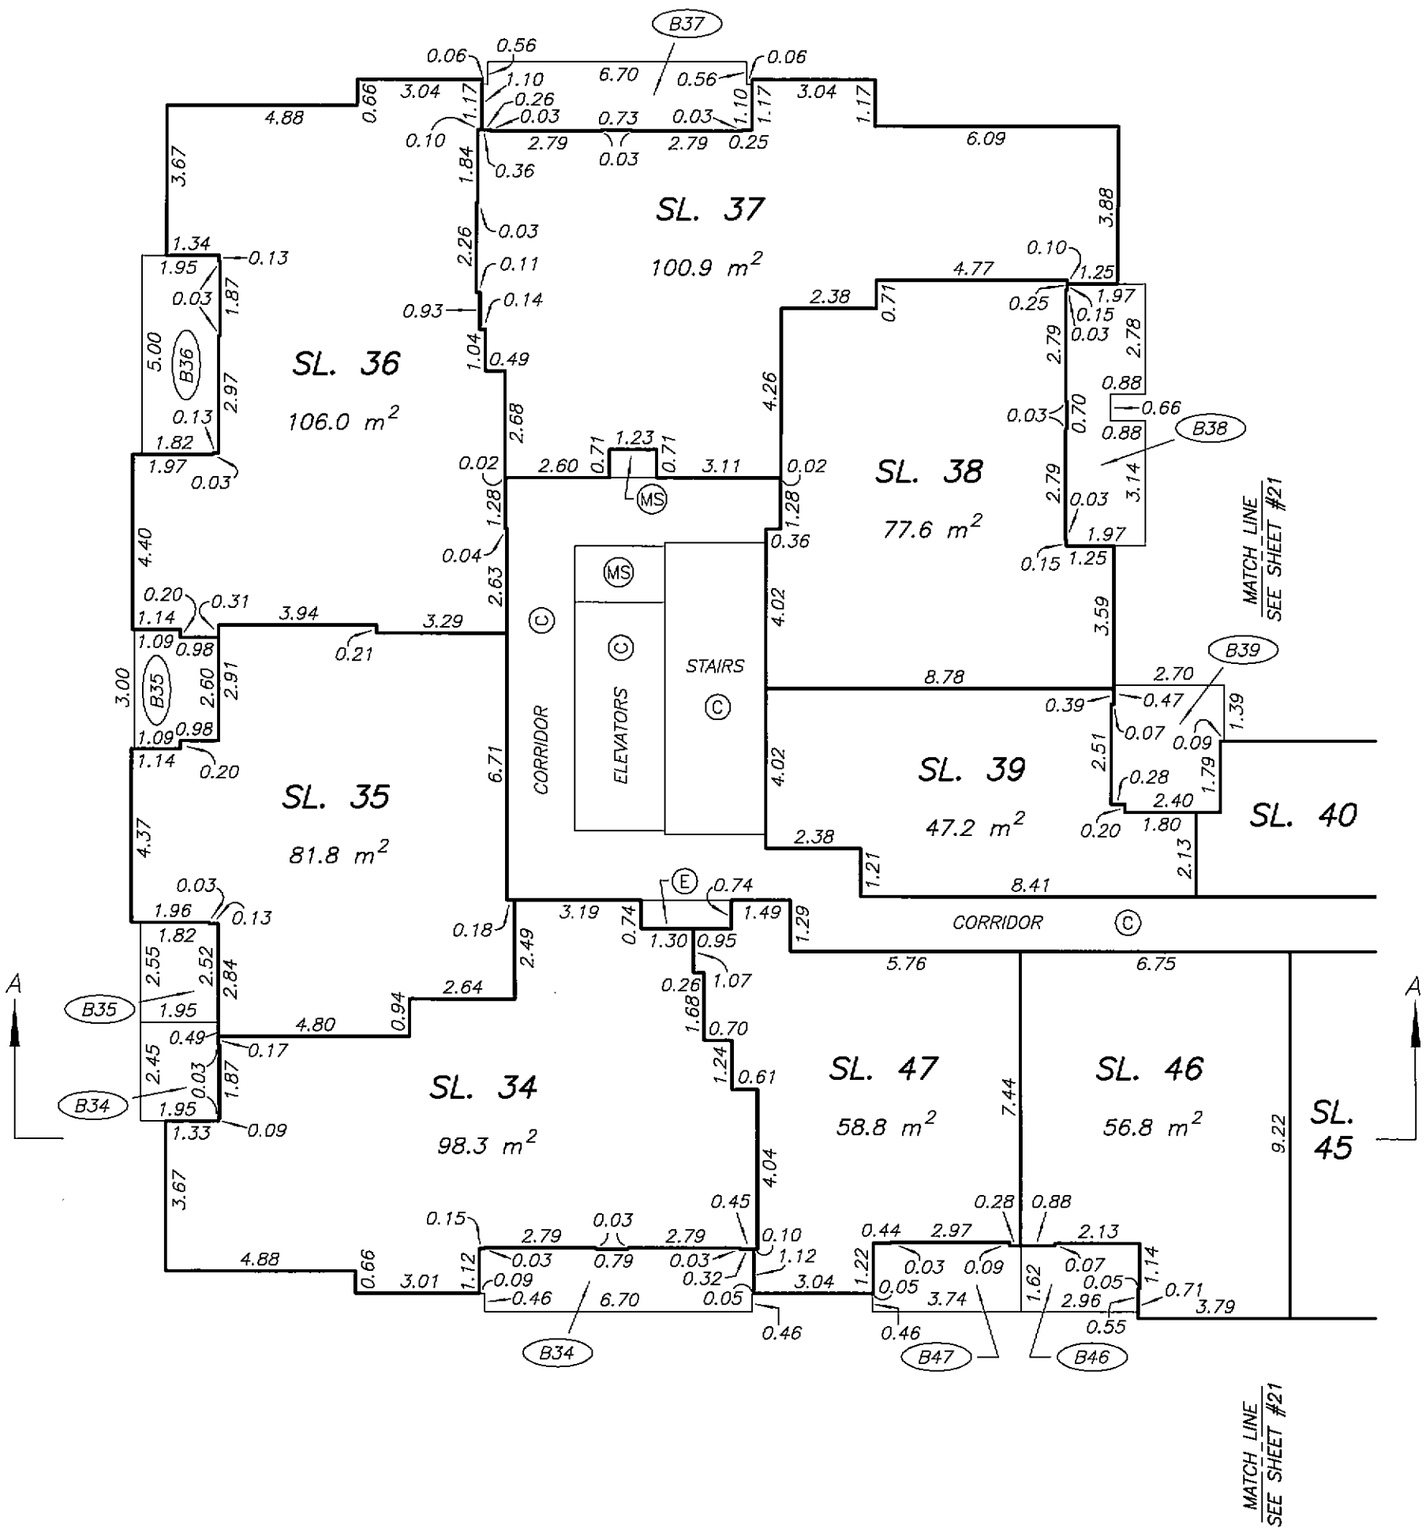

DATE : FEBRUARY 20, 2008

M.E.S.

DRAWING # 30624-10
FILE # 30624-10_L5

ORIGINAL

FILED NMBCS2855 RCVD:2008-04-16 RQST:2010-03-09-14.00.13.395

LEVEL 5 FLOOR PLAN EAST PORTION

STRATA PLAN BCS 2855

SCALE 1:150

2 0 2 4 6

ALL DISTANCES ARE IN METRES.

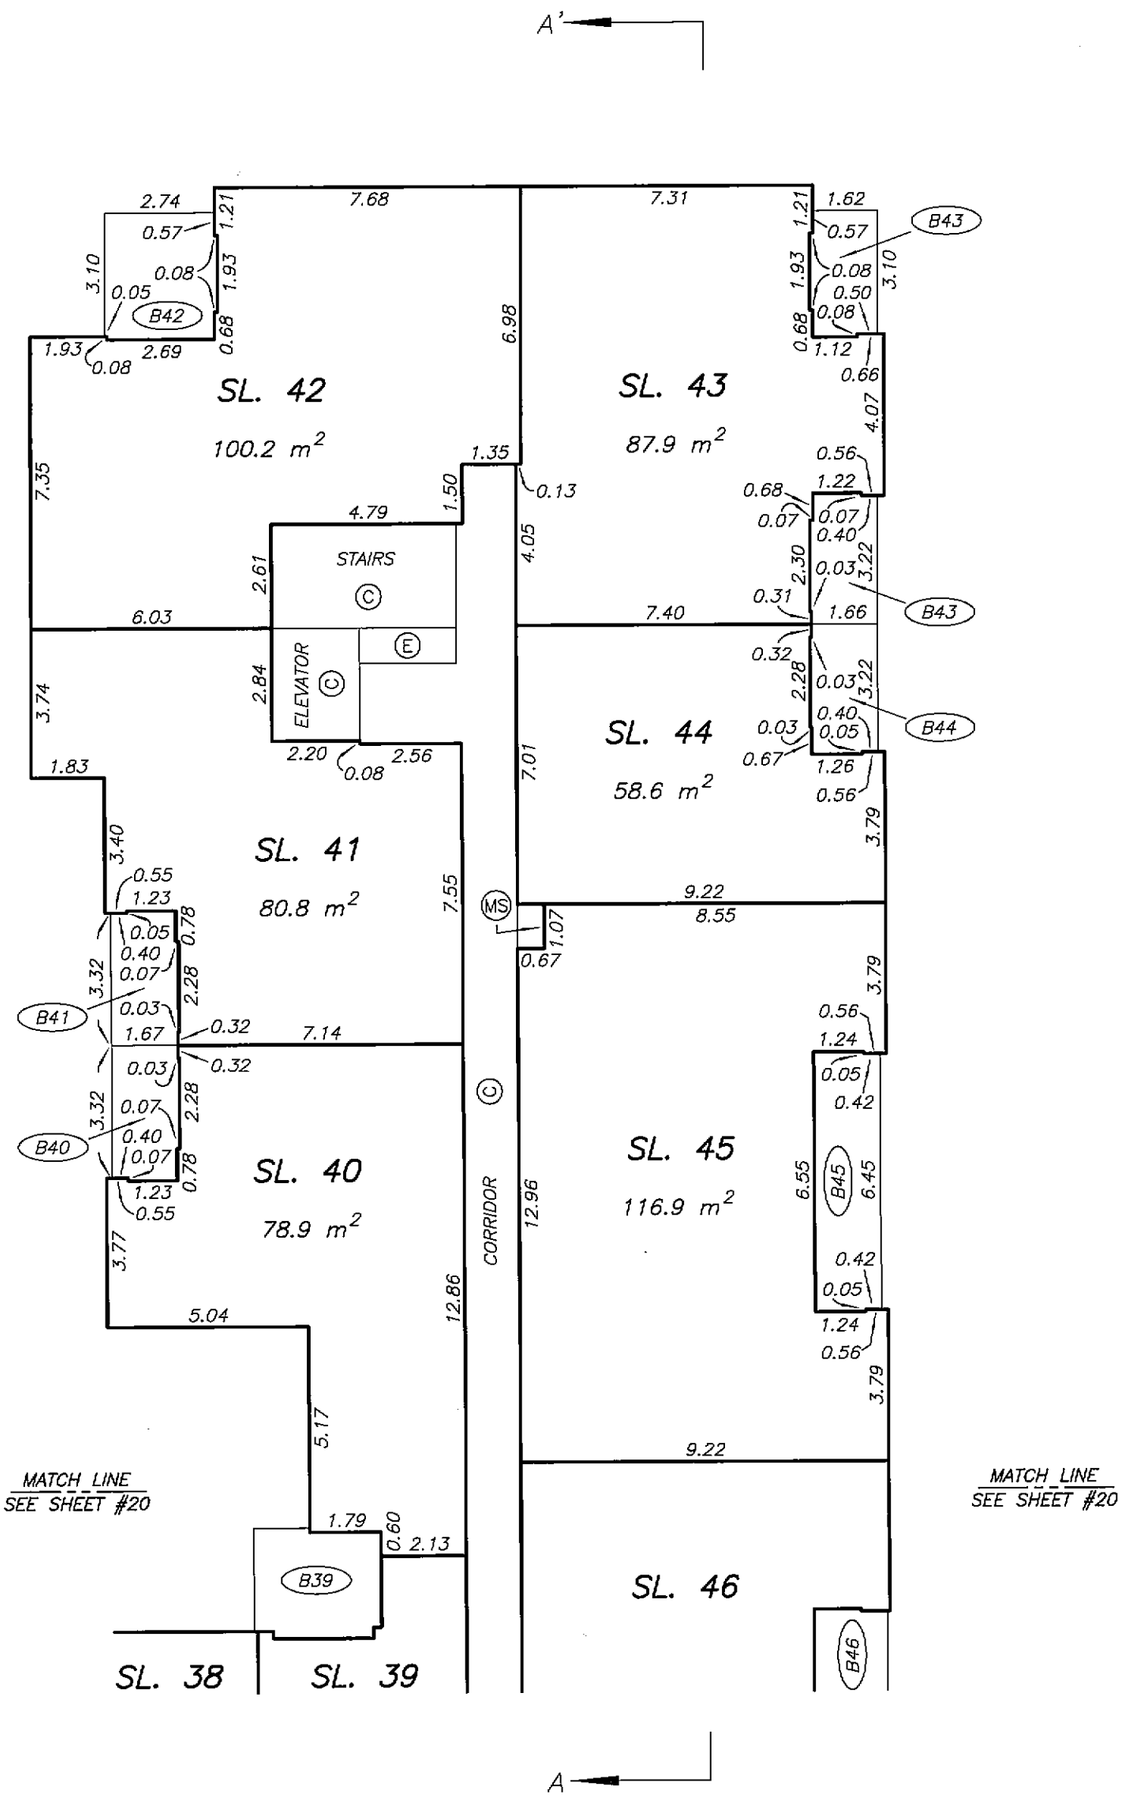

DATE : FEBRUARY 20, 2008

M.E.B.

DRAWING # 30624-10
FILE # 30624-10_L5

ORIGINAL

FILED NMBCS2855 RCVD:2008-04-16 RQST:2010-03-09-14.00.13.395

LEVEL 6
FLOOR PLAN
WEST PORTION

STRATA PLAN BCS 2855

SCALE 1:150

2 0 2 4 6

ALL DISTANCES ARE IN METRES.

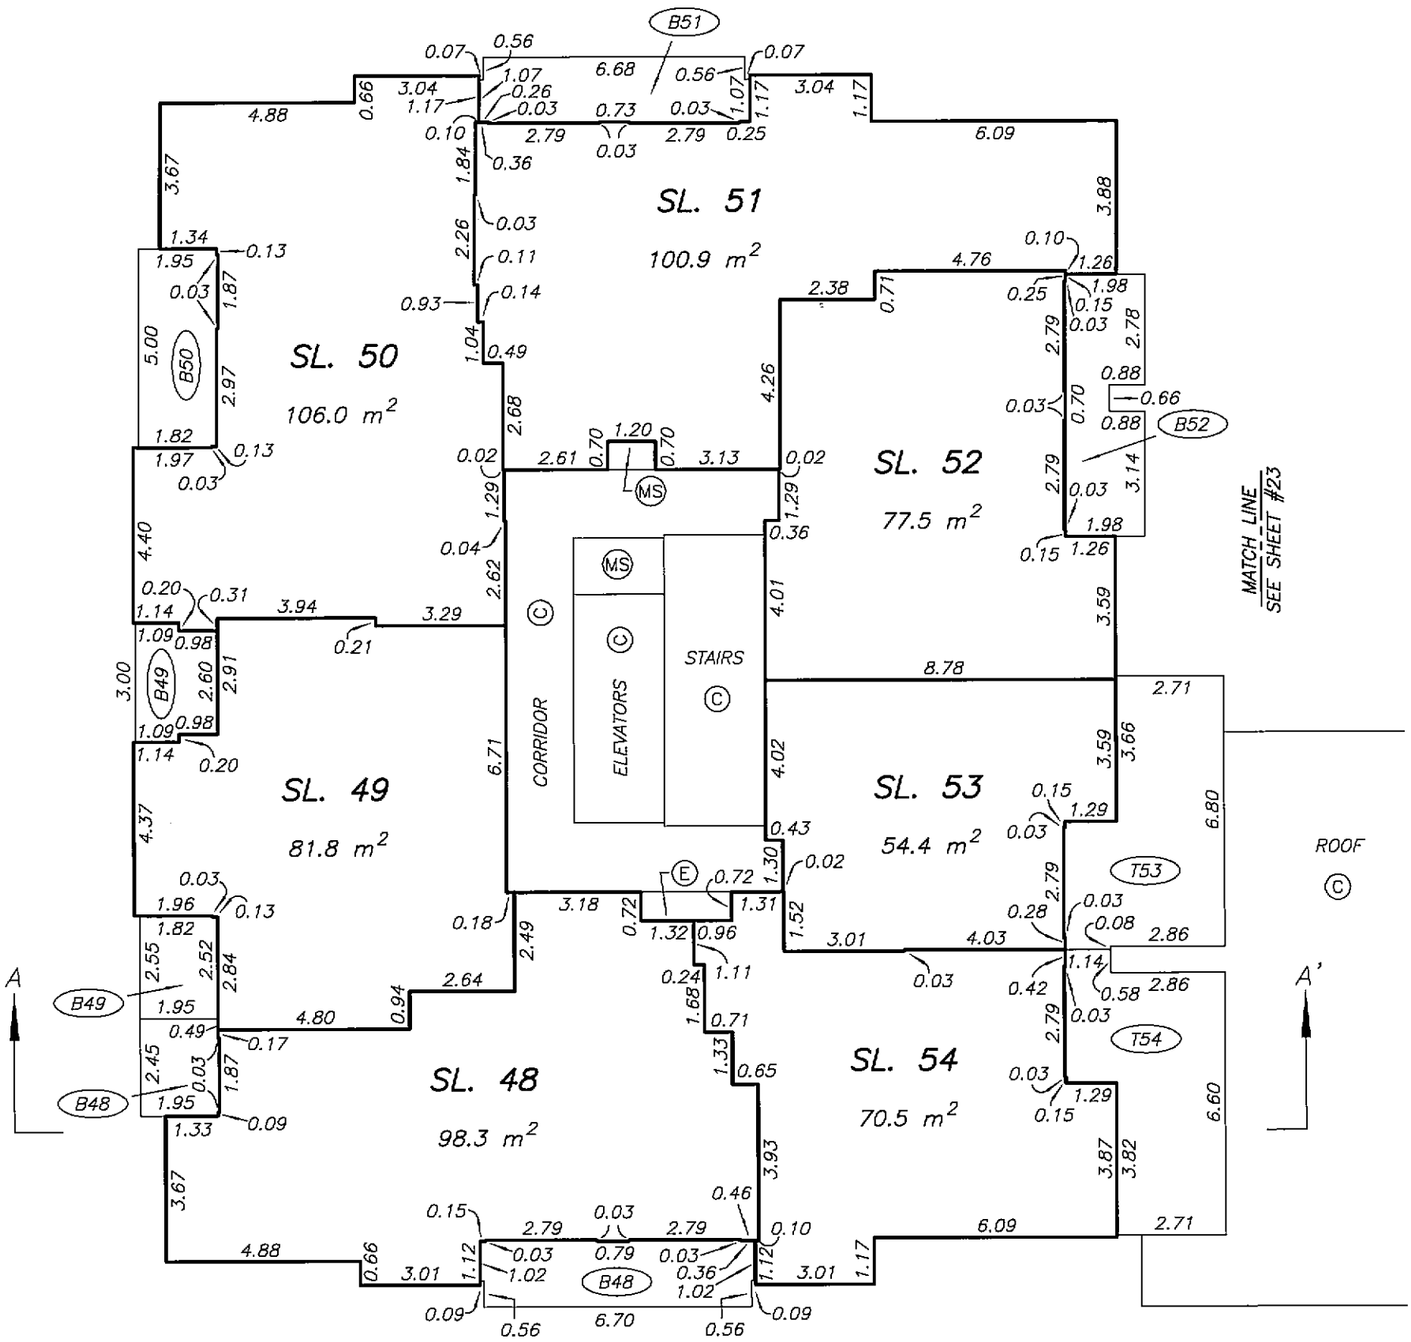

DATE : FEBRUARY 20, 2008

M.E.S.

DRAWING # 30624-10
FILE # 30624-10_L6

ORIGINAL

FILED NMBCS2855 RCVD:2008-04-16 RQST:2010-03-09-14.00.13.395

LEVEL 6 FLOOR PLAN EAST PORTION

STRATA PLAN BCS 2855

SCALE 1:150

2 0 2 4 6

ALL DISTANCES ARE IN METRES.

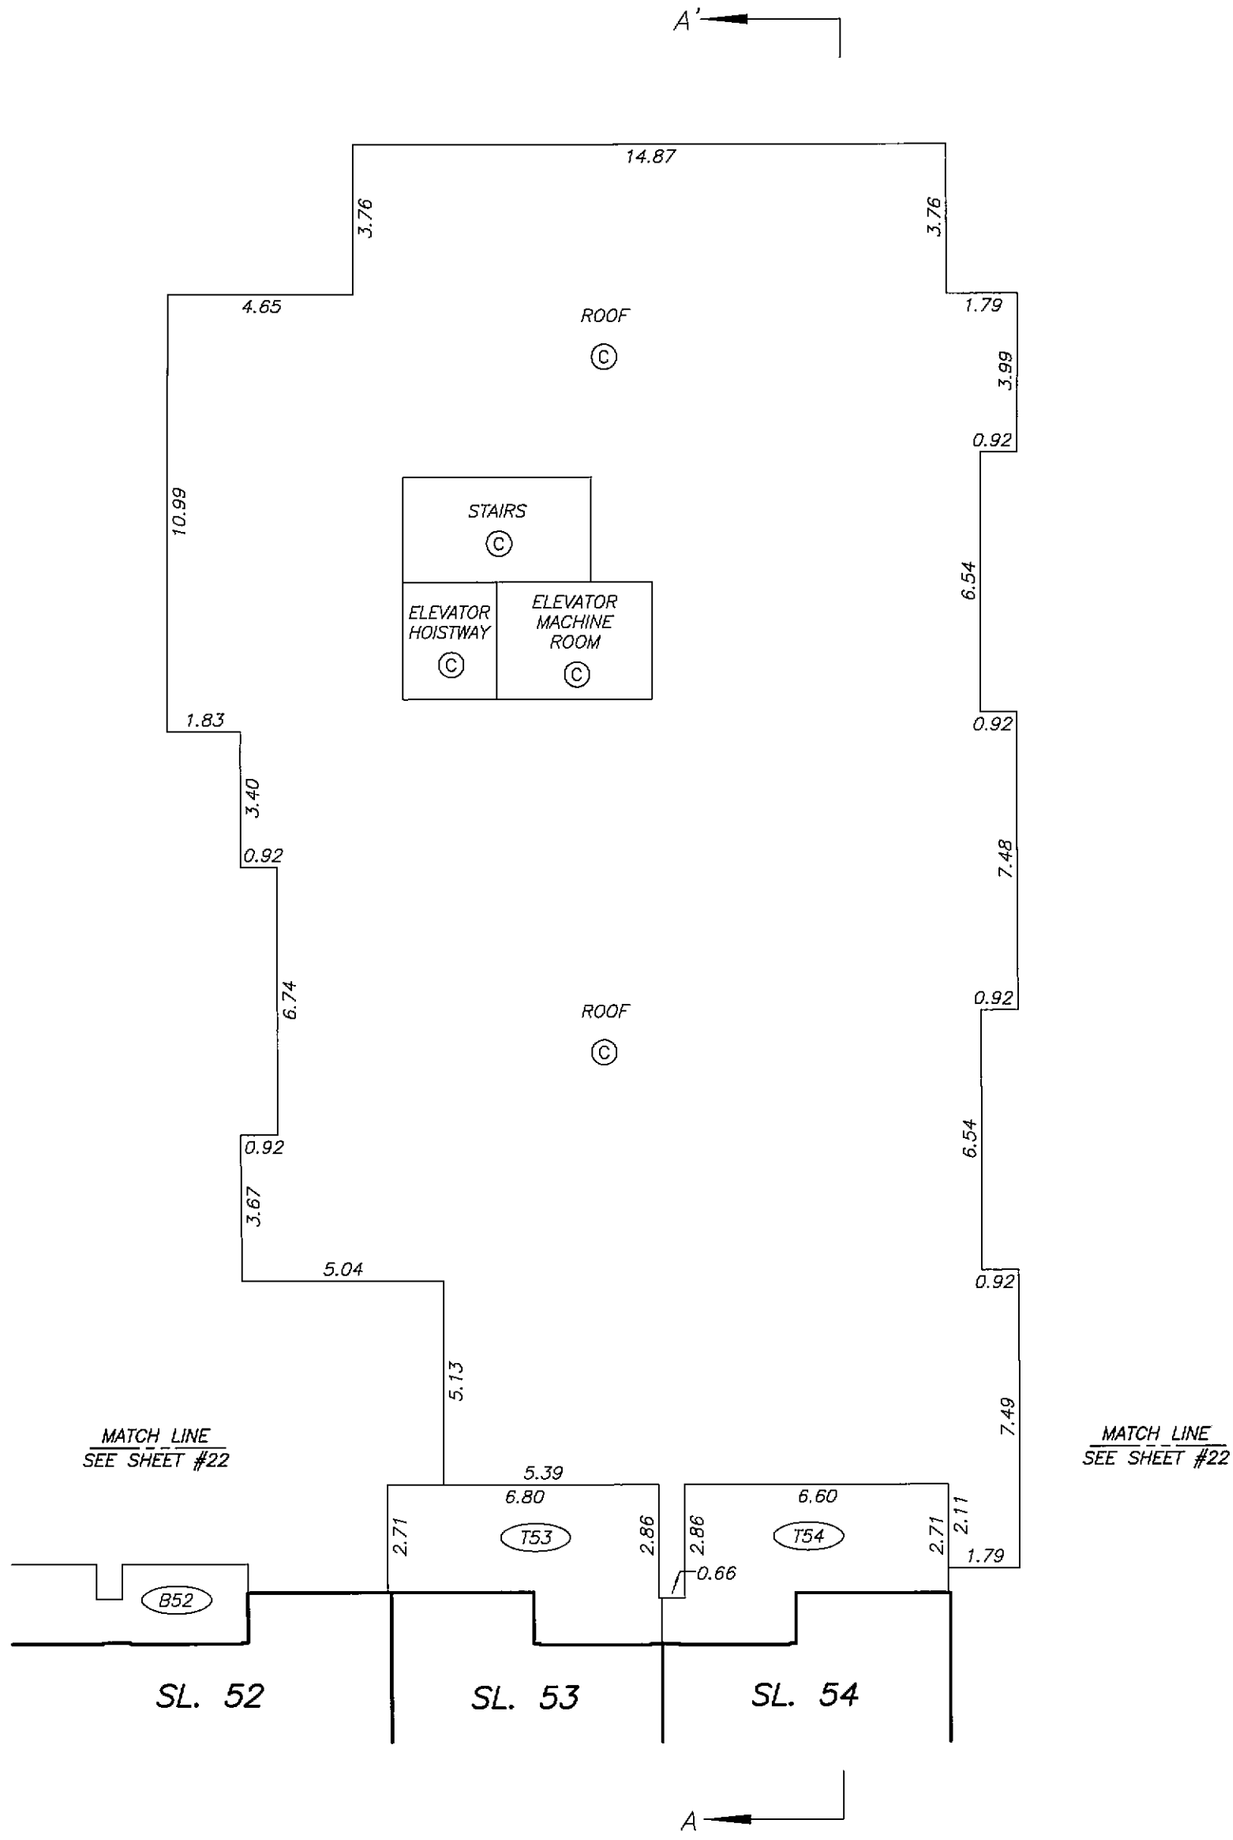

DATE : FEBRUARY 20, 2008

M. E. S.

DRAWING # 30624-10
FILE # 30624-10_L6

ORIGINAL

FILED NMBCS2855 RCVD:2008-04-16 RQST:2010-03-09-14.00.13.395

LEVEL 7 FLOOR PLAN

STRATA PLAN BCS 2855

SCALE 1:150

2 0 2 4 6

ALL DISTANCES ARE IN METRES.

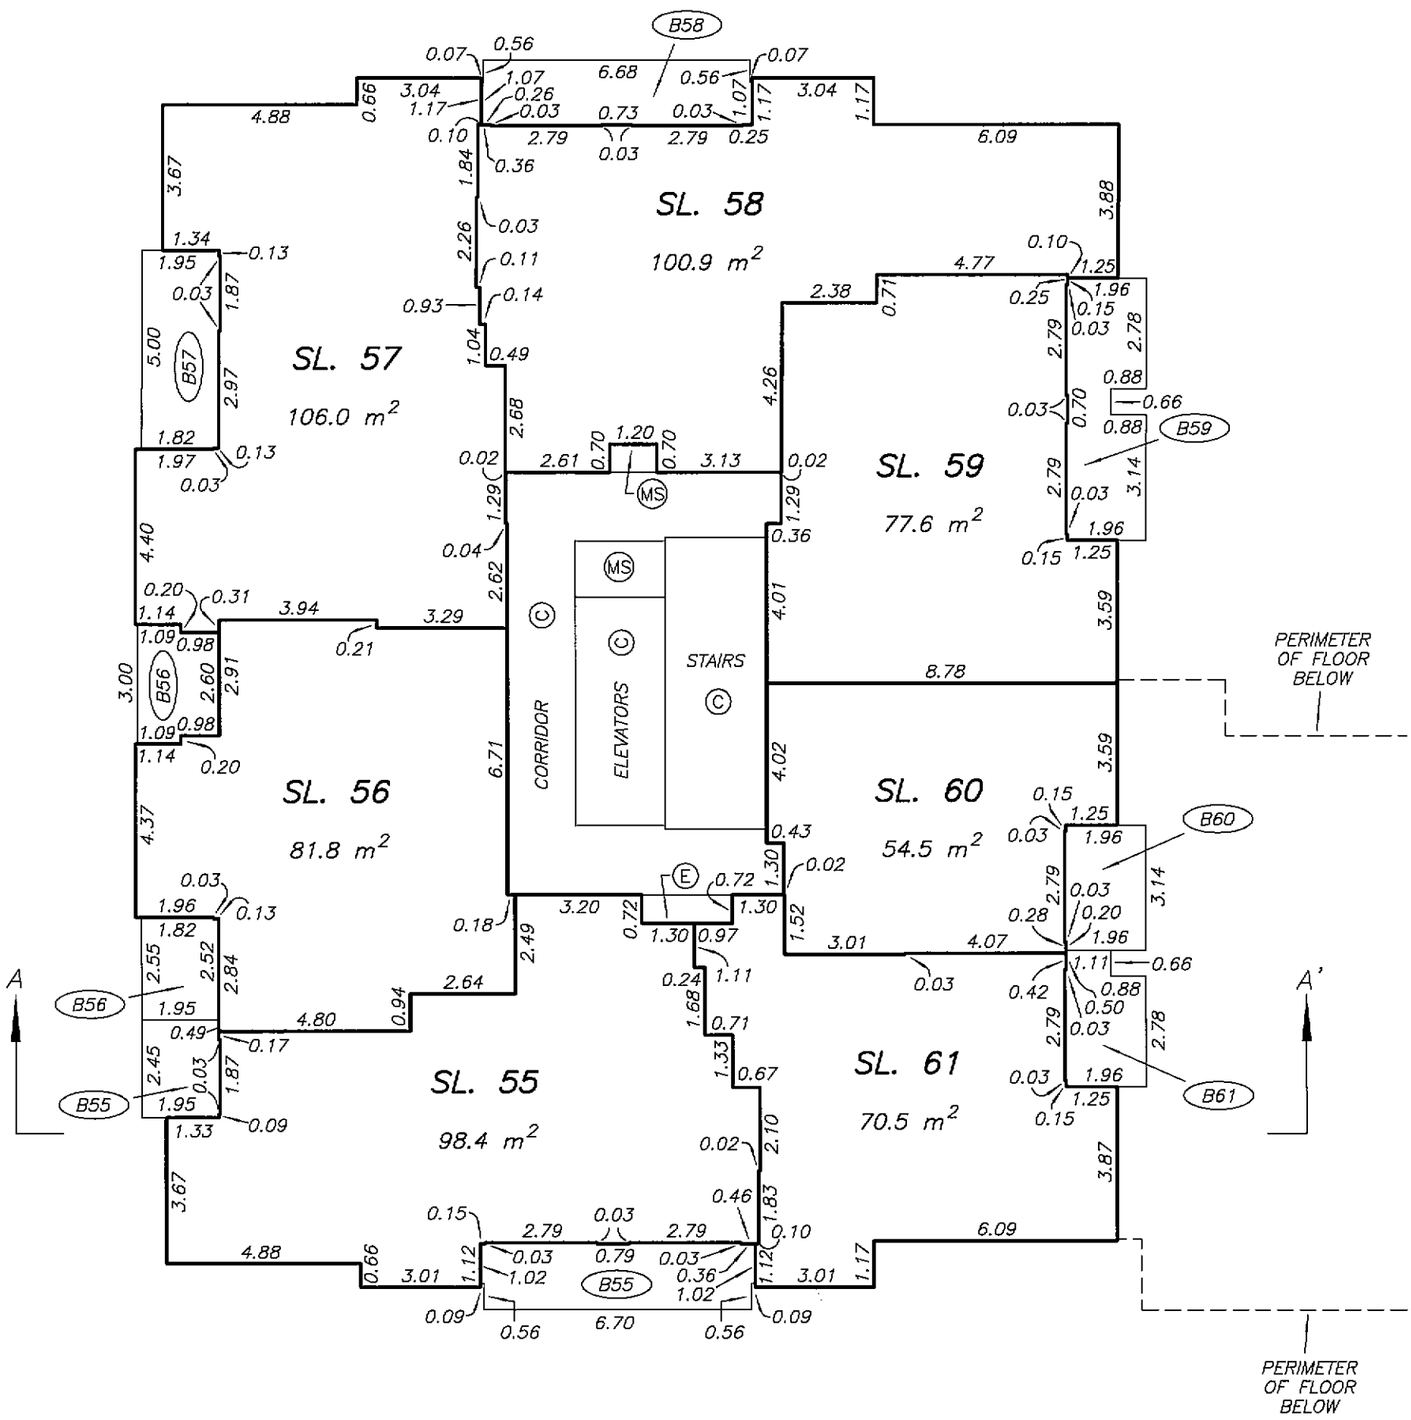

DATE : FEBRUARY 20, 2008

m.e.s.

DRAWING # 30624-10
FILE # 30624-10_L7

ORIGINAL

FILED NMBCS2855 RCVD:2008-04-16 RQST:2010-03-09-14.00.13.395

LEVEL 8 FLOOR PLAN

STRATA PLAN BCS 2855

SCALE 1:150

2 0 2 4 6

ALL DISTANCES ARE IN METRES.

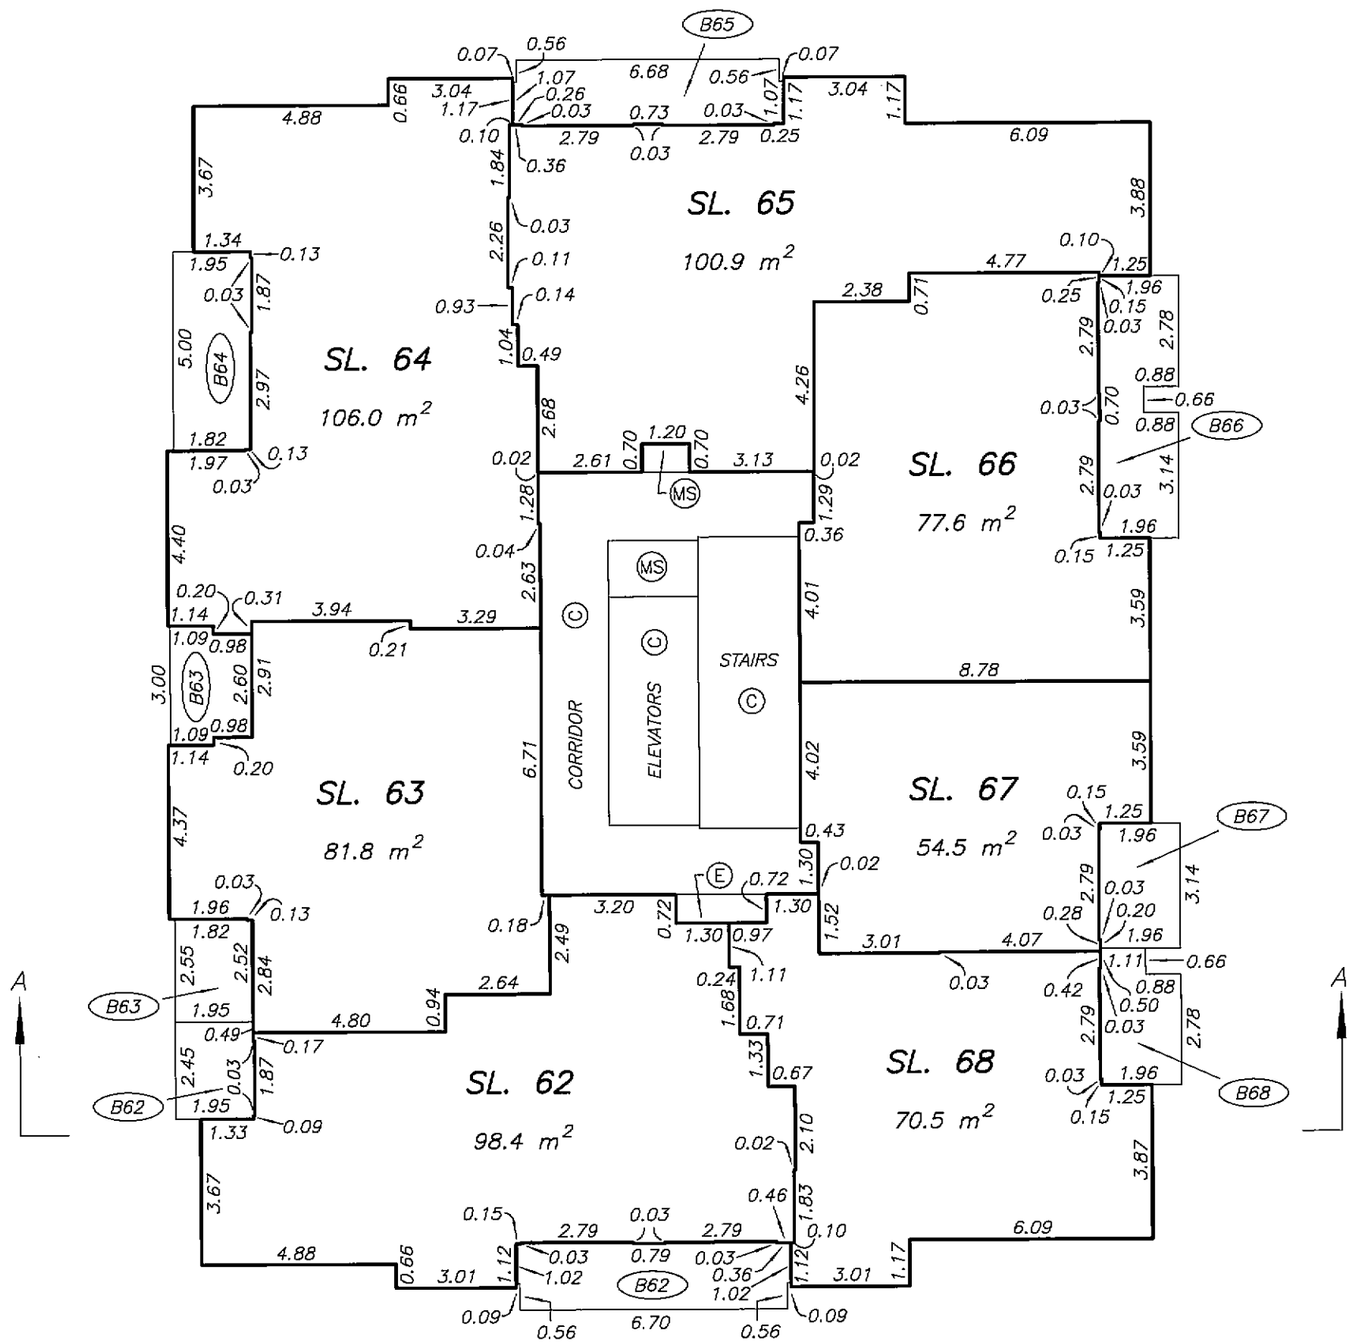

DATE : FEBRUARY 20, 2008

M.E.S.

DRAWING # 30624-10
FILE # 30624-10_L8

ORIGINAL

FILED NWBCS2855 RCVD:2008-04-16 RQST:2010-03-09-14.00.13.395

LEVEL 9 FLOOR PLAN

STRATA PLAN BCS 2855

SCALE 1:150

2 0 2 4 6

ALL DISTANCES ARE IN METRES.

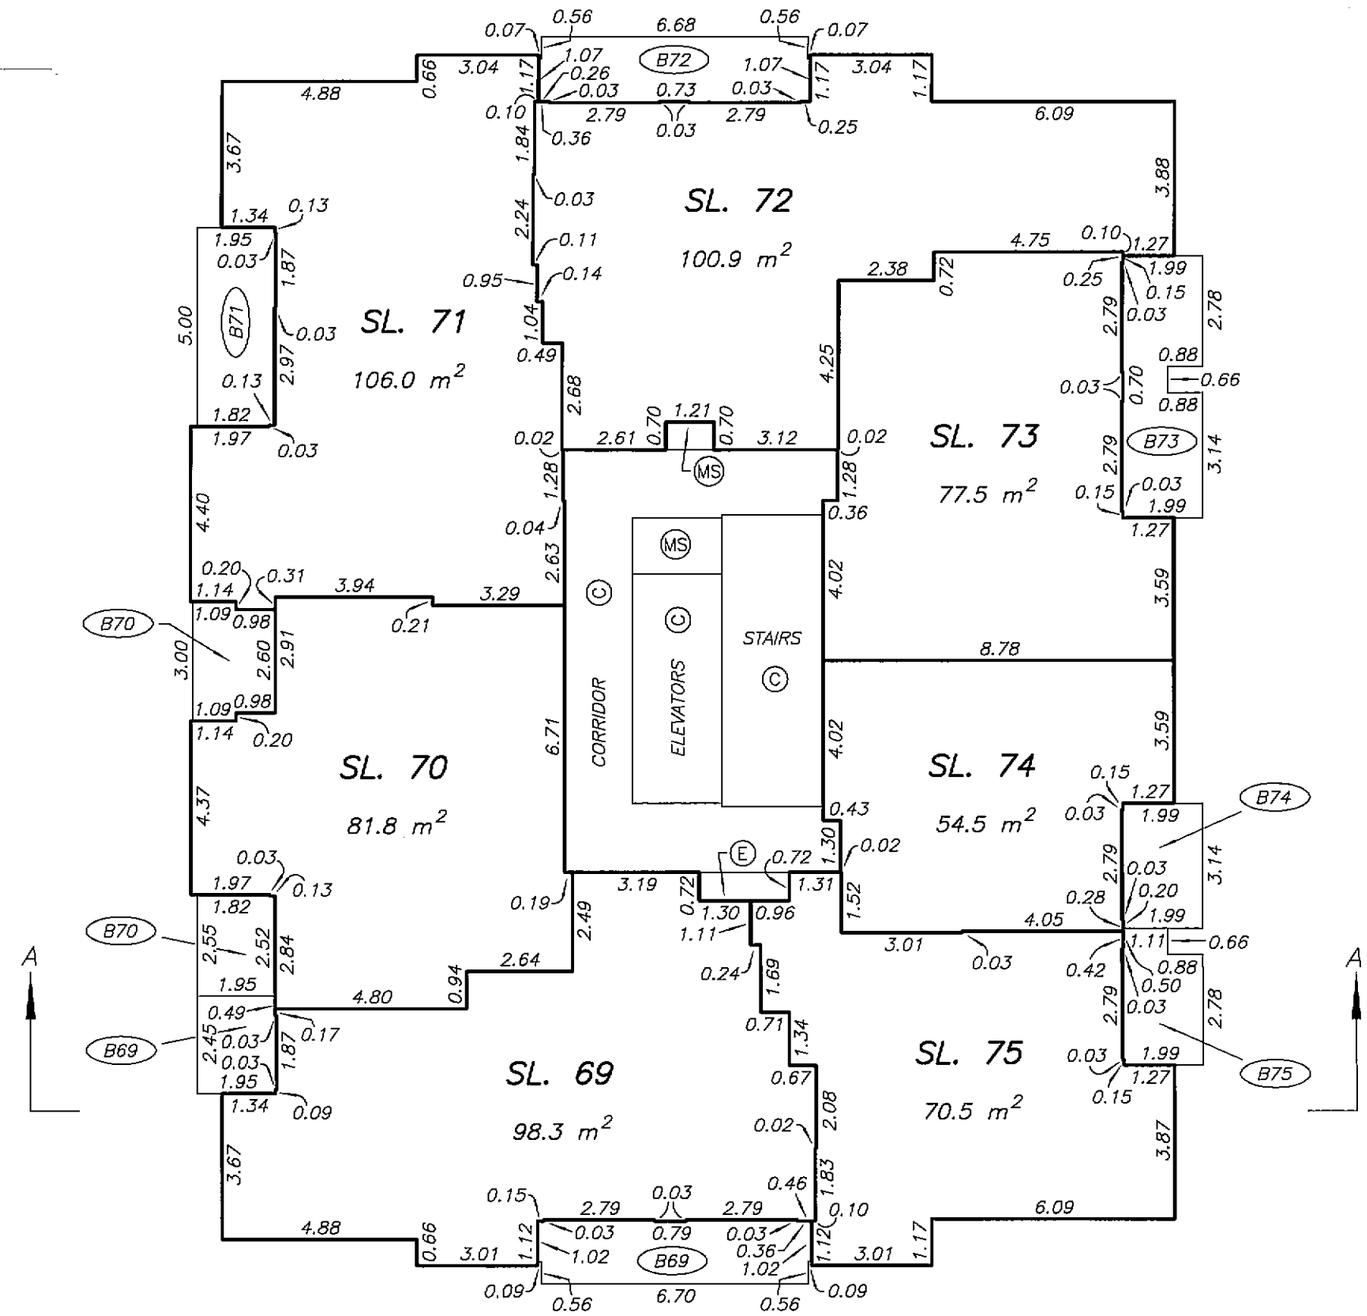

DRAWING # 30624-10
FILE # 30624-10_L9

DATE : FEBRUARY 20, 2008

M.E.S.

ORIGINAL

FILED NWBCS2855 RCVD:2008-04-16 RQST:2010-03-09-14.00.13.395

LEVEL 10 FLOOR PLAN

STRATA PLAN BCS 2855

SCALE 1:150

2 0 2 4 6

ALL DISTANCES ARE IN METRES.

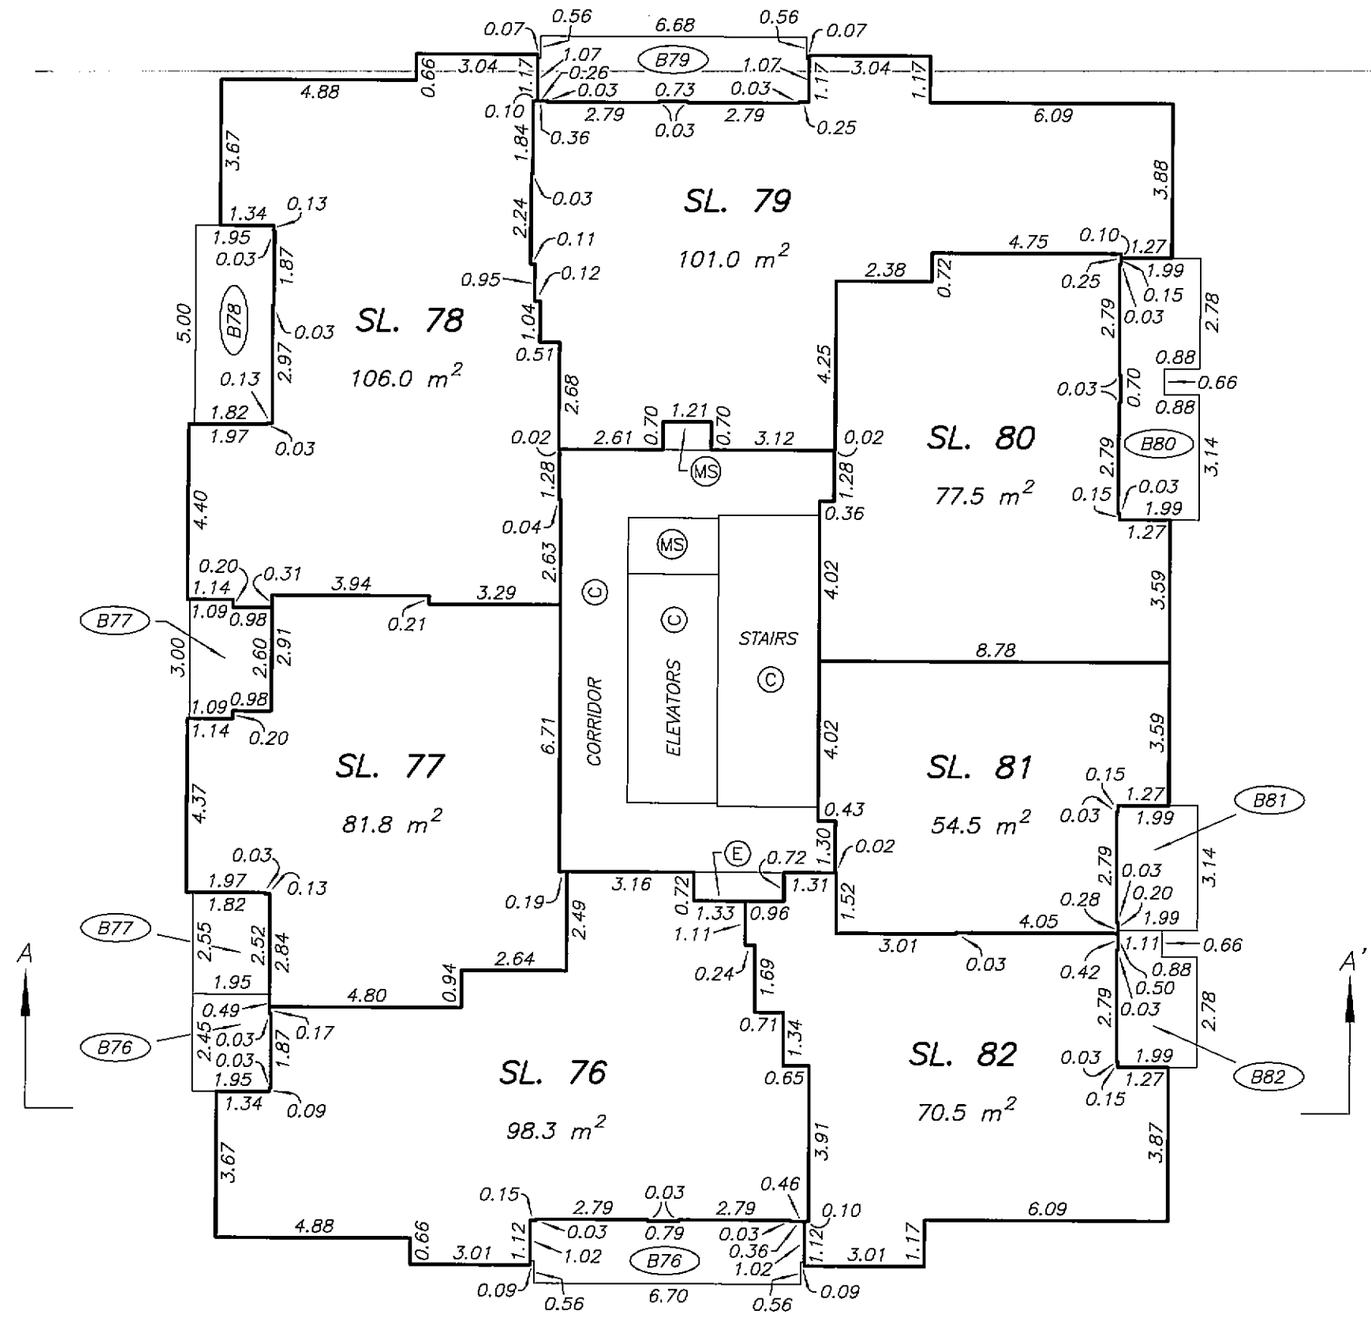

DATE : FEBRUARY 20, 2008

M.E.S.

DRAWING # 30624-10
FILE # 30624-10_L10

ORIGINAL

FILED NMBCS2855 RCVD:2008-04-16 RQST:2010-03-09-14.00.13.395

LEVEL 11 FLOOR PLAN

STRATA PLAN BCS 2855

SCALE 1:150

2 0 2 4 6

ALL DISTANCES ARE IN METRES.

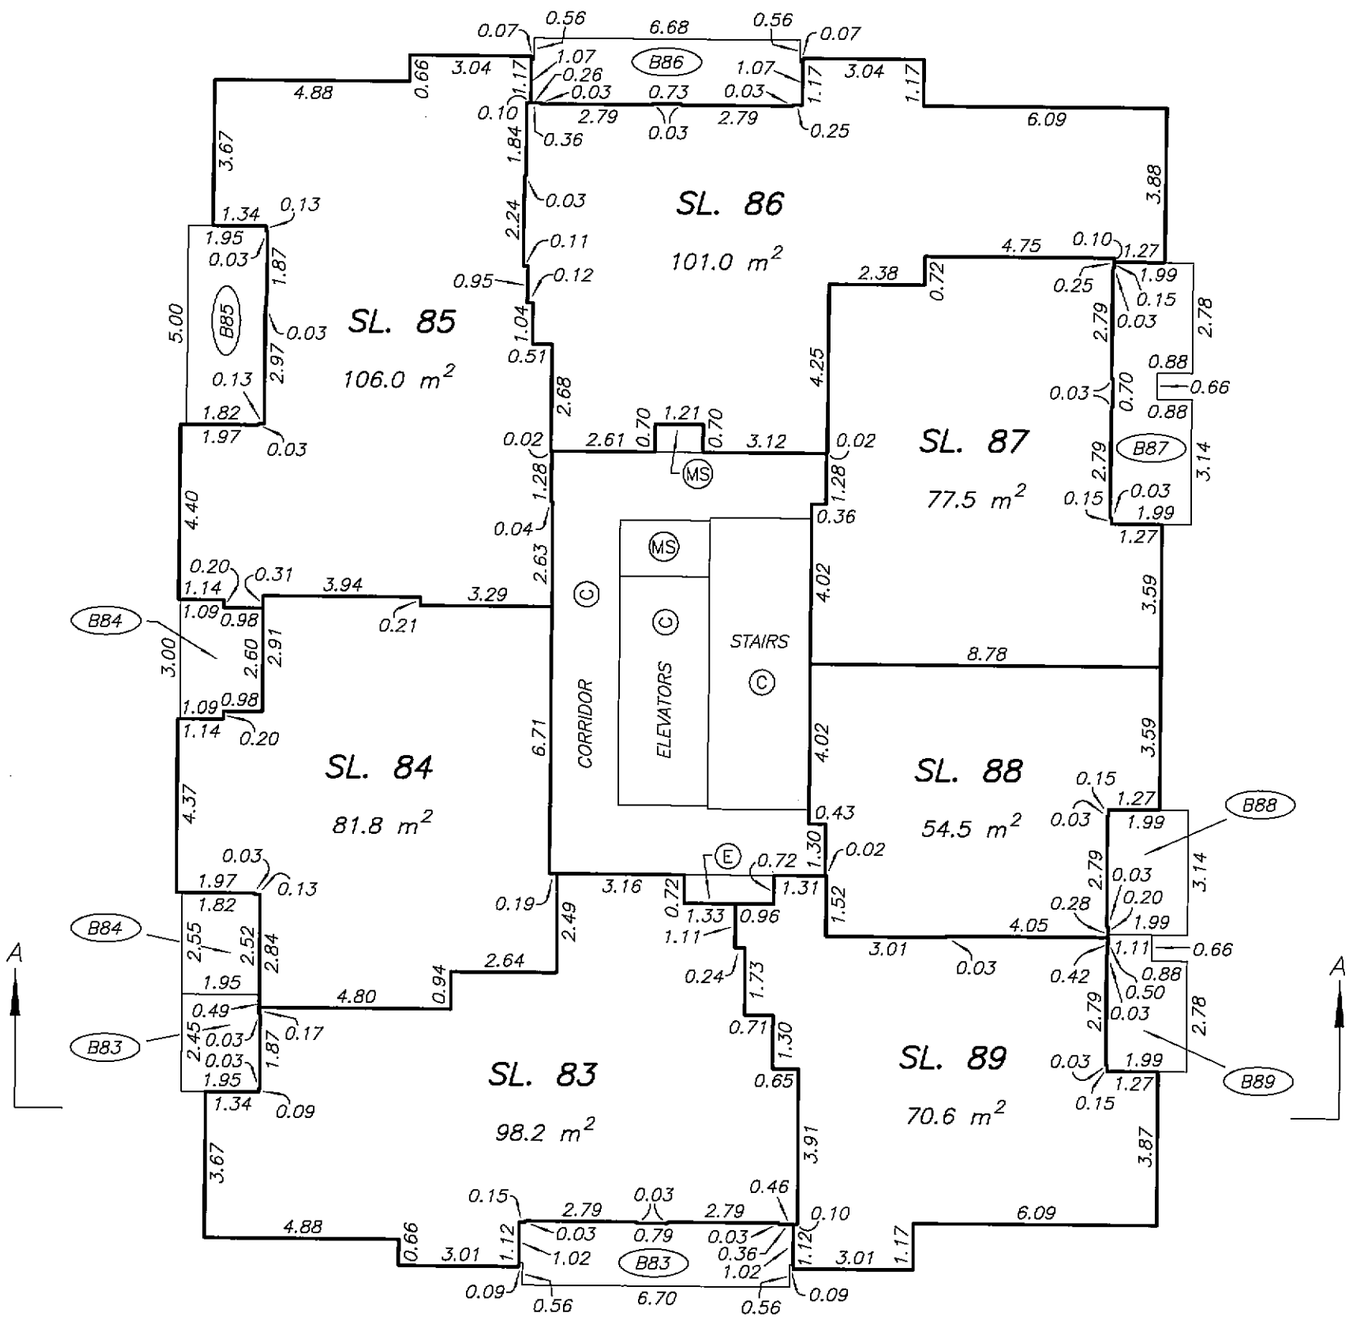

DRAWING # 30624-10
FILE # 30624-10_L11

DATE : FEBRUARY 20, 2008

M.E.S.

ORIGINAL

FILED NMBCS2855 RCVD:2008-04-16 RQST:2010-03-09-14.00.13.395

LEVEL 12 FLOOR PLAN

STRATA PLAN BCS 2855

SCALE 1:150

2 0 2 4 6

ALL DISTANCES ARE IN METRES.

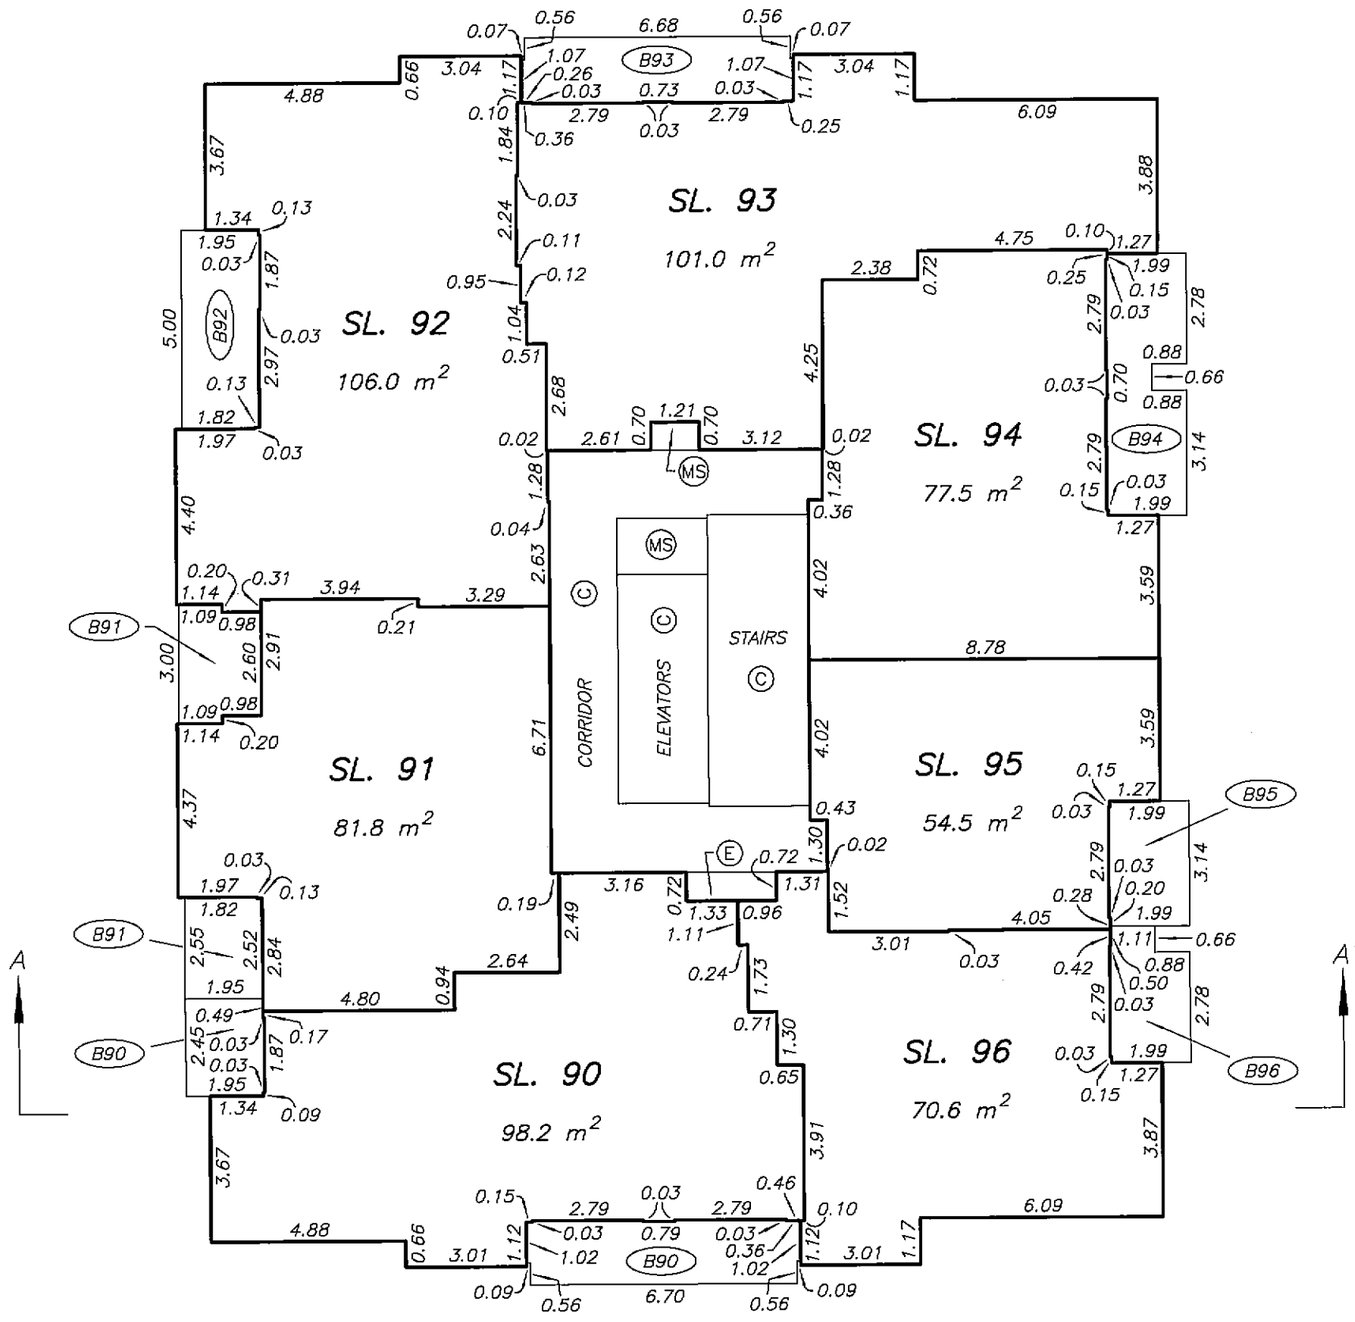

DATE : FEBRUARY 20, 2008

M.E.S.

DRAWING # 30624-10
FILE # 30624-10_L12

ORIGINAL

FILED NWBCS2855 RCVD:2008-04-16 RQST:2010-03-09-14.00.13.395

LEVEL 14 FLOOR PLAN

STRATA PLAN BCS 2855

SCALE 1:150

2 0 2 4 6

ALL DISTANCES ARE IN METRES.

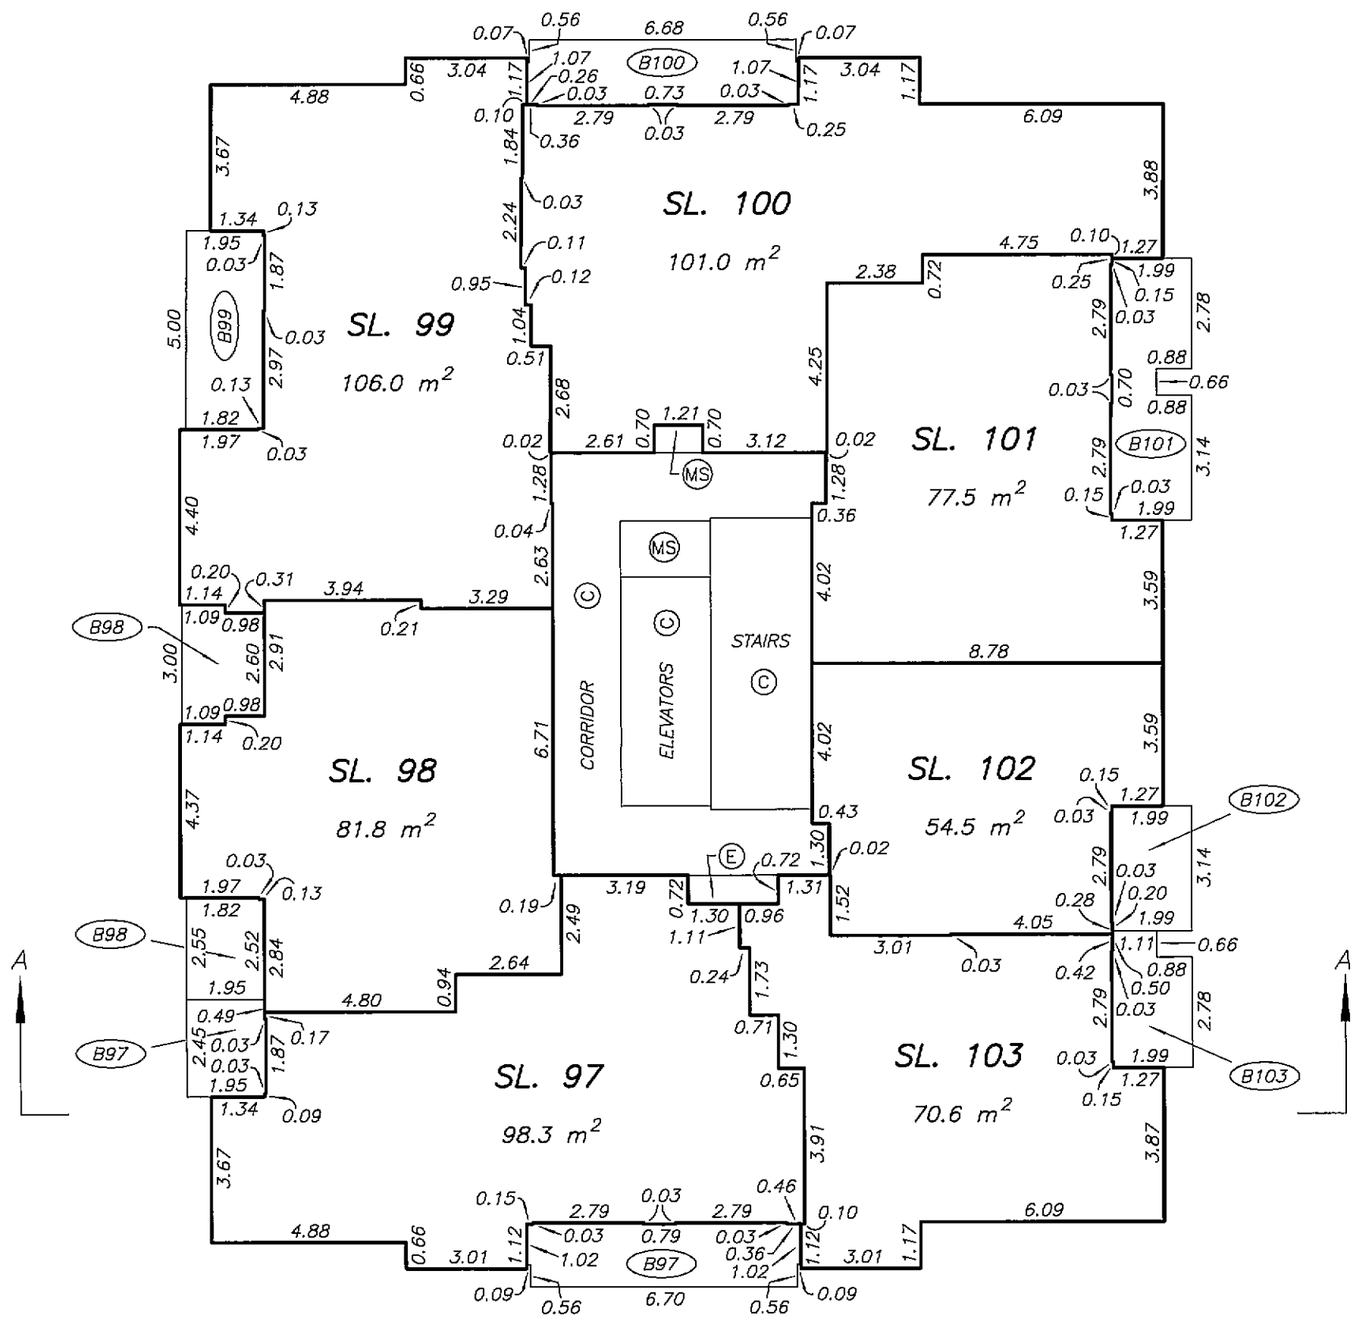

DRAWING # 30624-10
FILE # 30624-10_L14

DATE : FEBRUARY 20, 2008

M.E.S.

ORIGINAL

FILED NWBCS2855 RCVD:2008-04-16 RQST:2010-03-09-14.00.13.395

LEVEL 15 FLOOR PLAN

STRATA PLAN BCS 2855

SCALE 1:150

2 0 2 4 6

ALL DISTANCES ARE IN METRES.

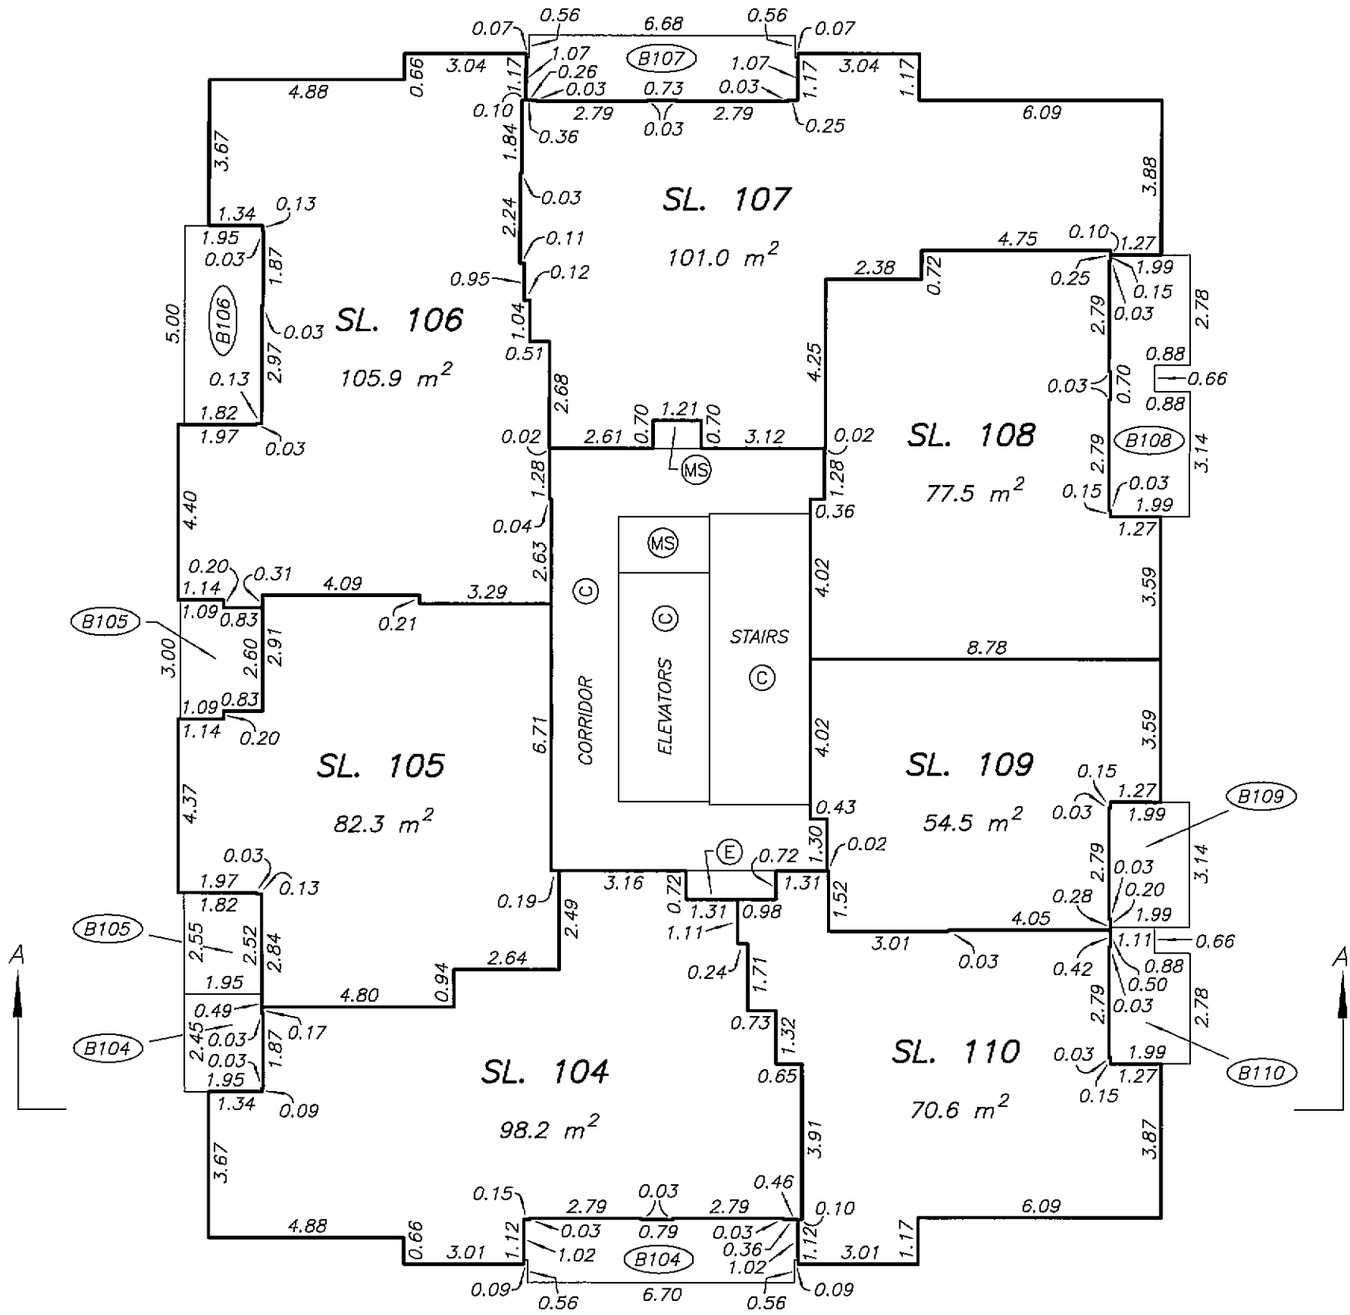

DATE : FEBRUARY 20, 2008

M.E.S.

DRAWING # 30624-10
FILE # 30624-10_L15

ORIGINAL

FILED NWBCS2855 RCVD:2008-04-16 RQST:2010-03-09-14.00.13.395

LEVEL 16 FLOOR PLAN

STRATA PLAN BCS 2855

SCALE 1:150

2 0 2 4 6

ALL DISTANCES ARE IN METRES.

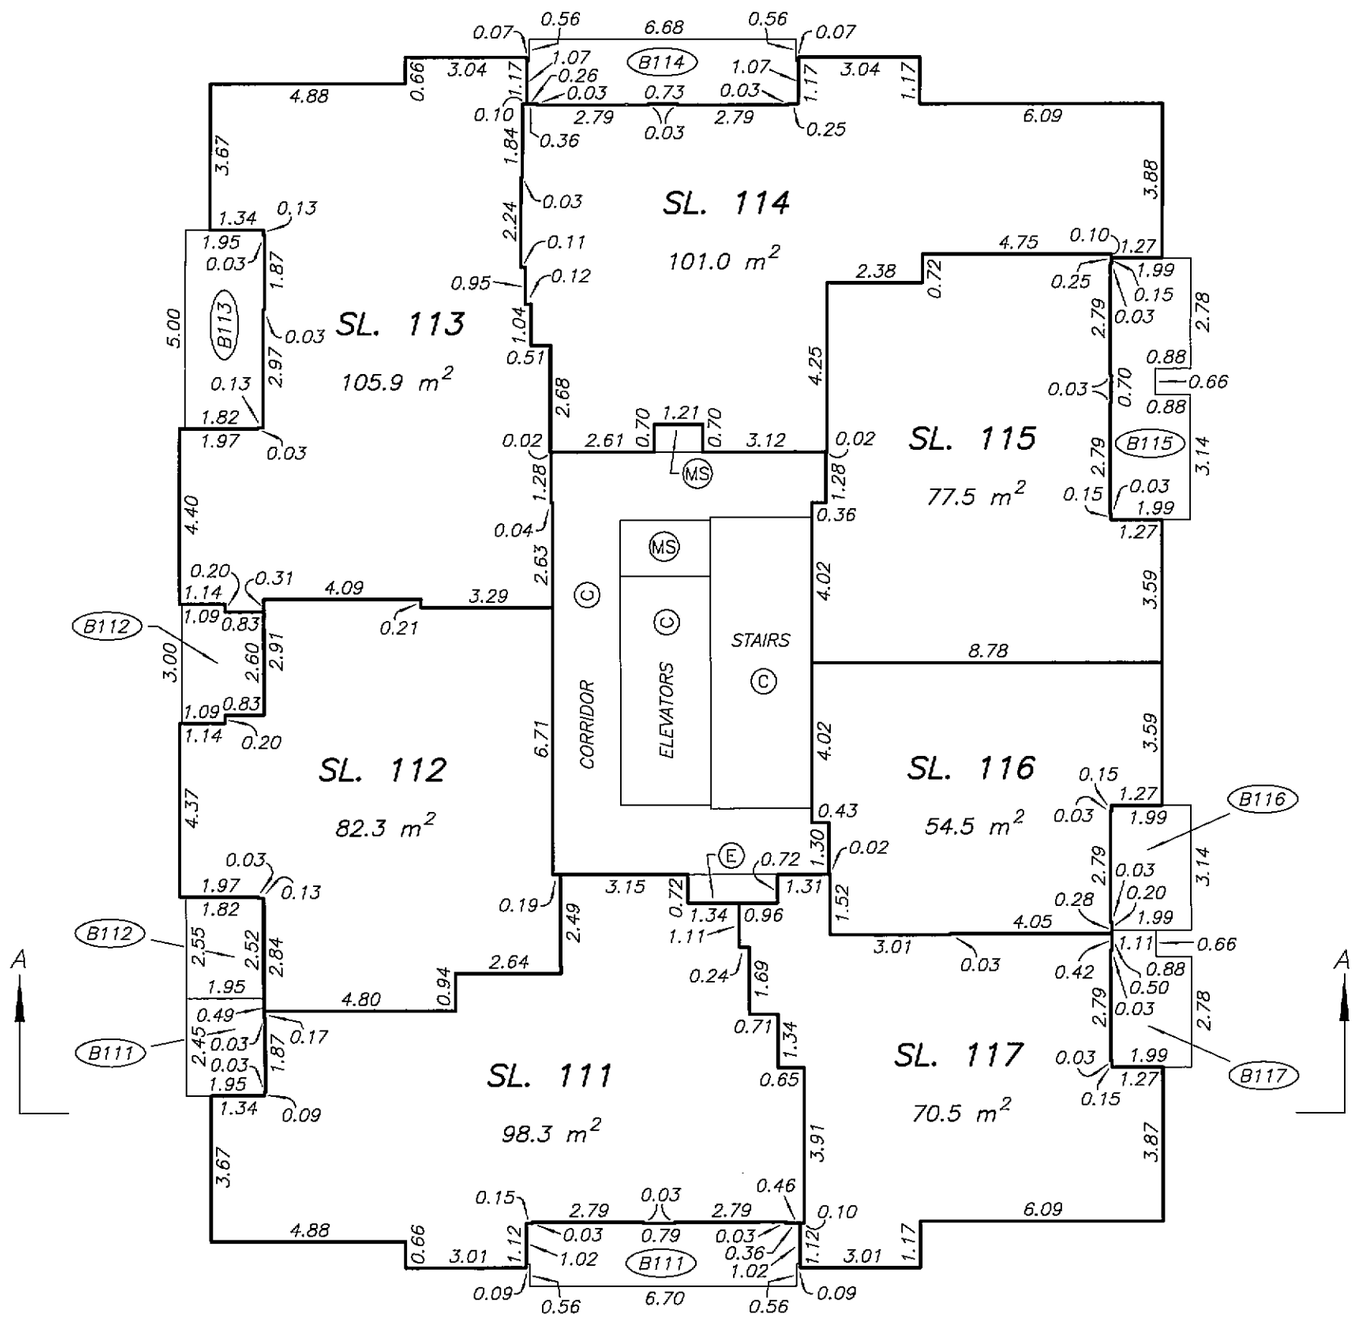

DATE : FEBRUARY 20, 2008

M. E. S.

DRAWING # 30624-10
FILE # 30624-10_L16

ORIGINAL

FILED NWBCS2855 RCVD:2008-04-16 RQST:2010-03-09-14.00.13.395

LEVEL 17 FLOOR PLAN

STRATA PLAN BCS 2855

SCALE 1:150

2 0 2 4 6

ALL DISTANCES ARE IN METRES.

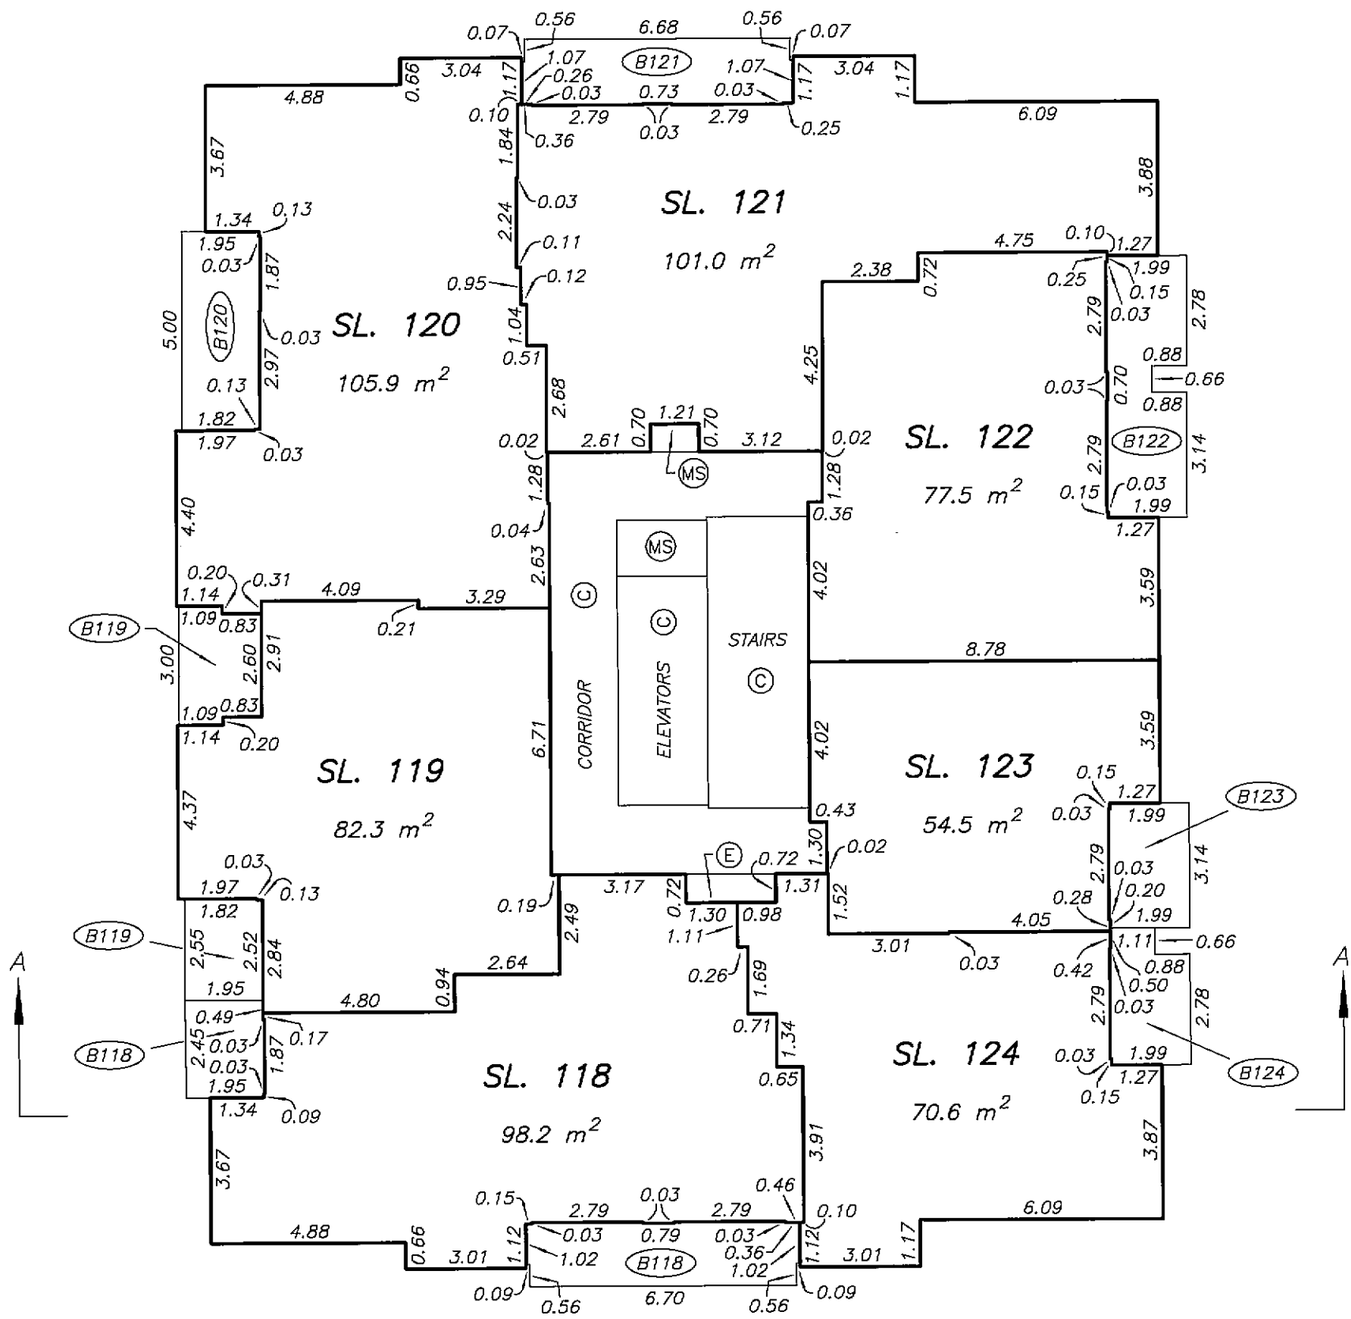

DATE : FEBRUARY 20, 2008

M.E.S.

DRAWING # 30624-10
FILE # 30624-10_L17

ORIGINAL

FILED NWBCS2855 RCVD:2008-04-16 RQST:2010-03-09-14.00.13.395

LEVEL 18 FLOOR PLAN

STRATA PLAN BCS 2855

SCALE 1:150

2 0 2 4 6

ALL DISTANCES ARE IN METRES.

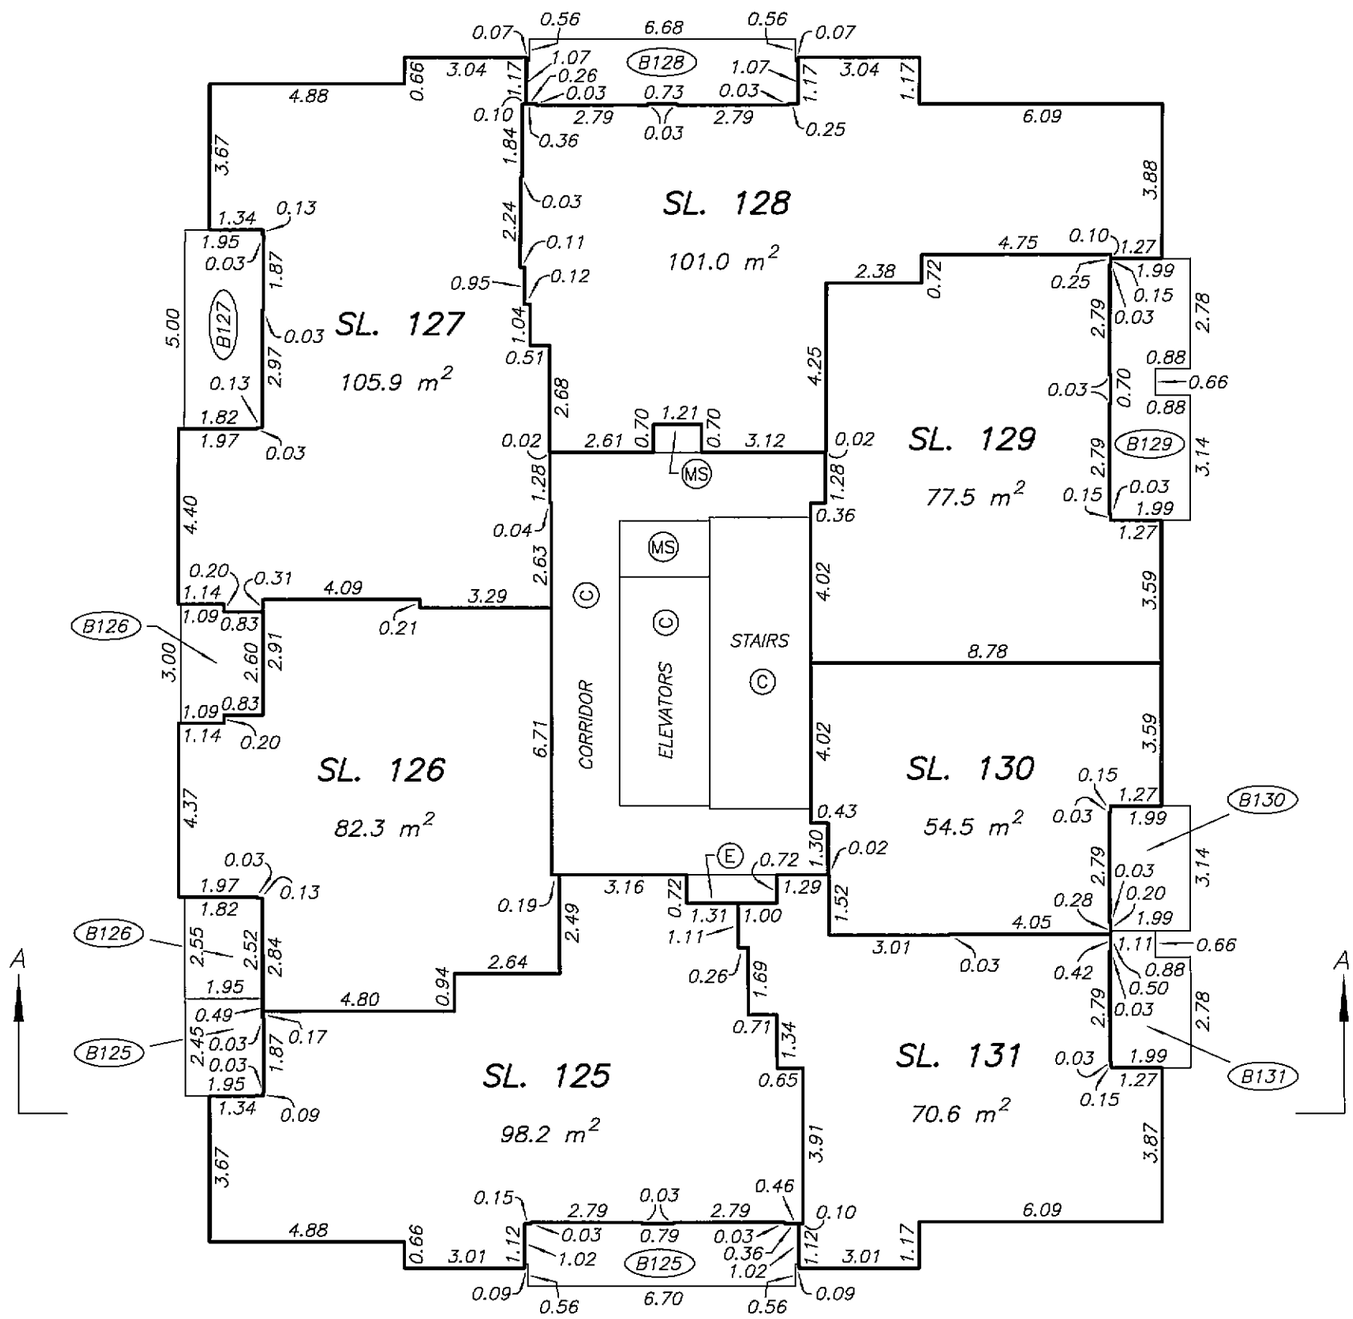

DATE : FEBRUARY 20, 2008

M.E.B.

DRAWING # 30624-10
FILE # 30624-10_L18

ORIGINAL

FILED NMBCS2855 RCVD:2008-04-16 RQST:2010-03-09-14.00.13.395

LEVEL 19 FLOOR PLAN

STRATA PLAN BCS 2855

SCALE 1:150

2 0 2 4 6

ALL DISTANCES ARE IN METRES.

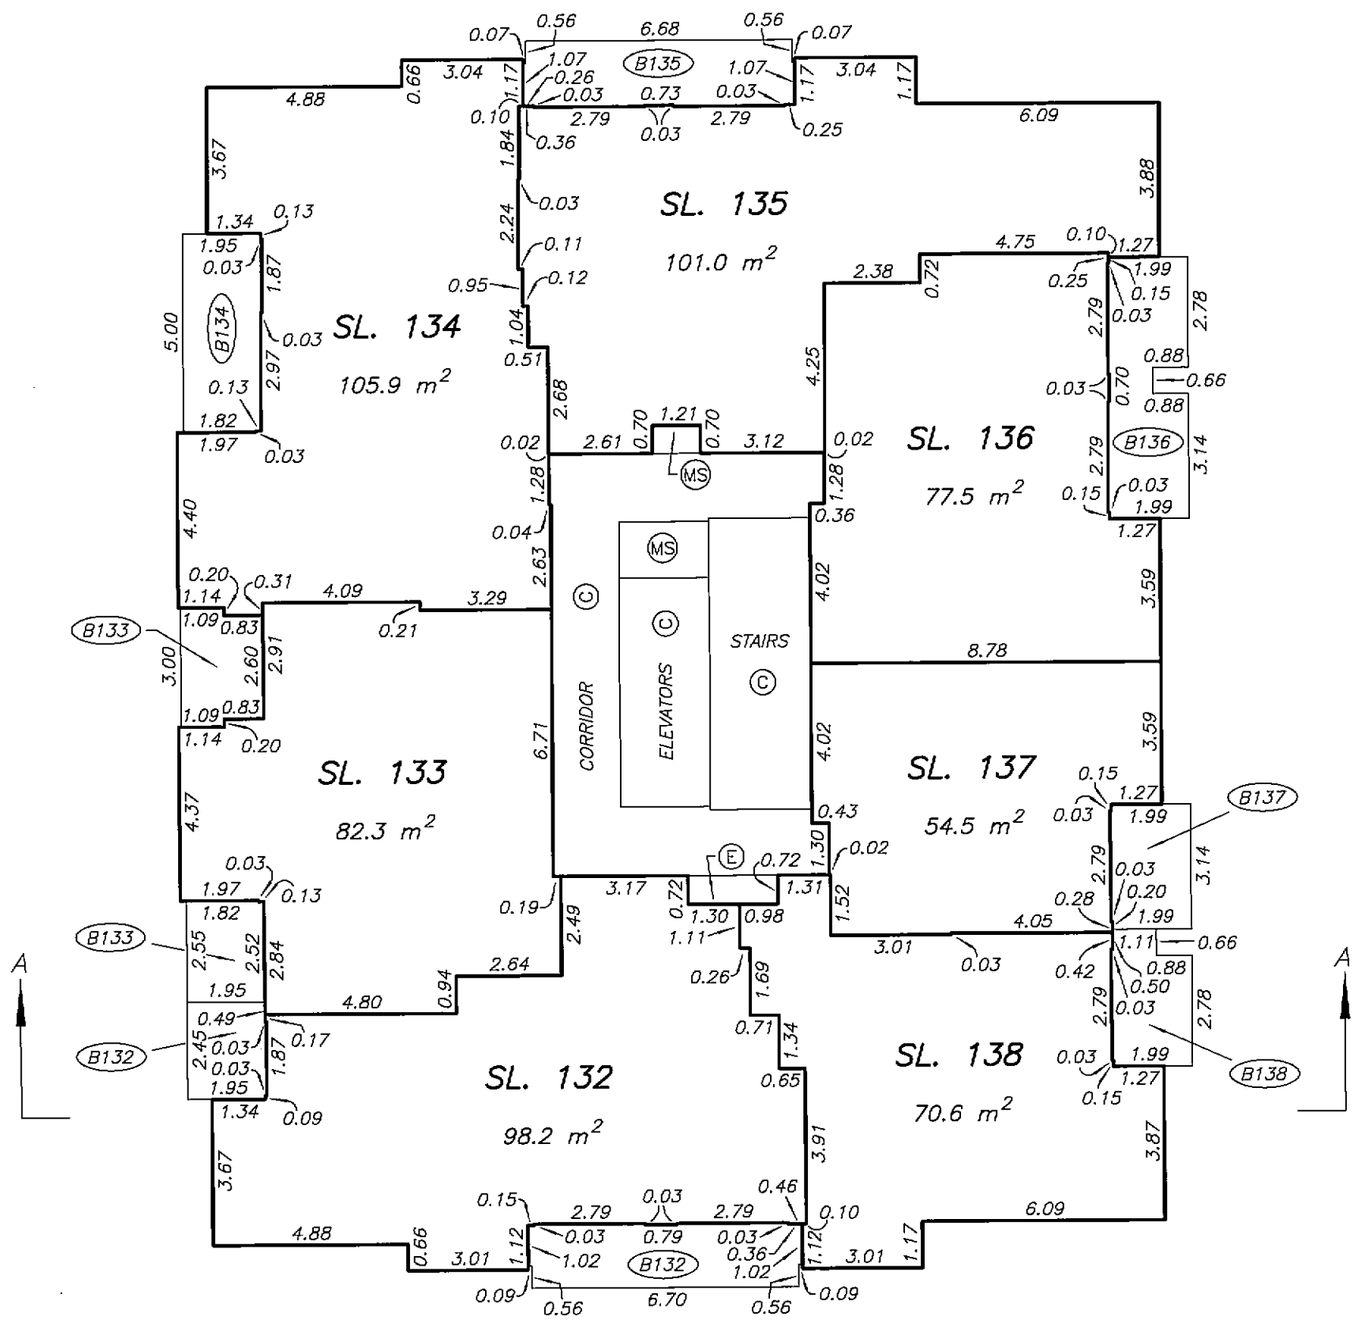

DATE : FEBRUARY 20, 2008

M.E.B.

DRAWING # 30624-10
FILE # 30624-10_L19

ORIGINAL

FILED NWBCS2855 RCVD:2008-04-16 RQST:2010-03-09-14.00.13.395

LEVEL 20 FLOOR PLAN

STRATA PLAN BCS 2855

SCALE 1:150

2 0 2 4 6

ALL DISTANCES ARE IN METRES.

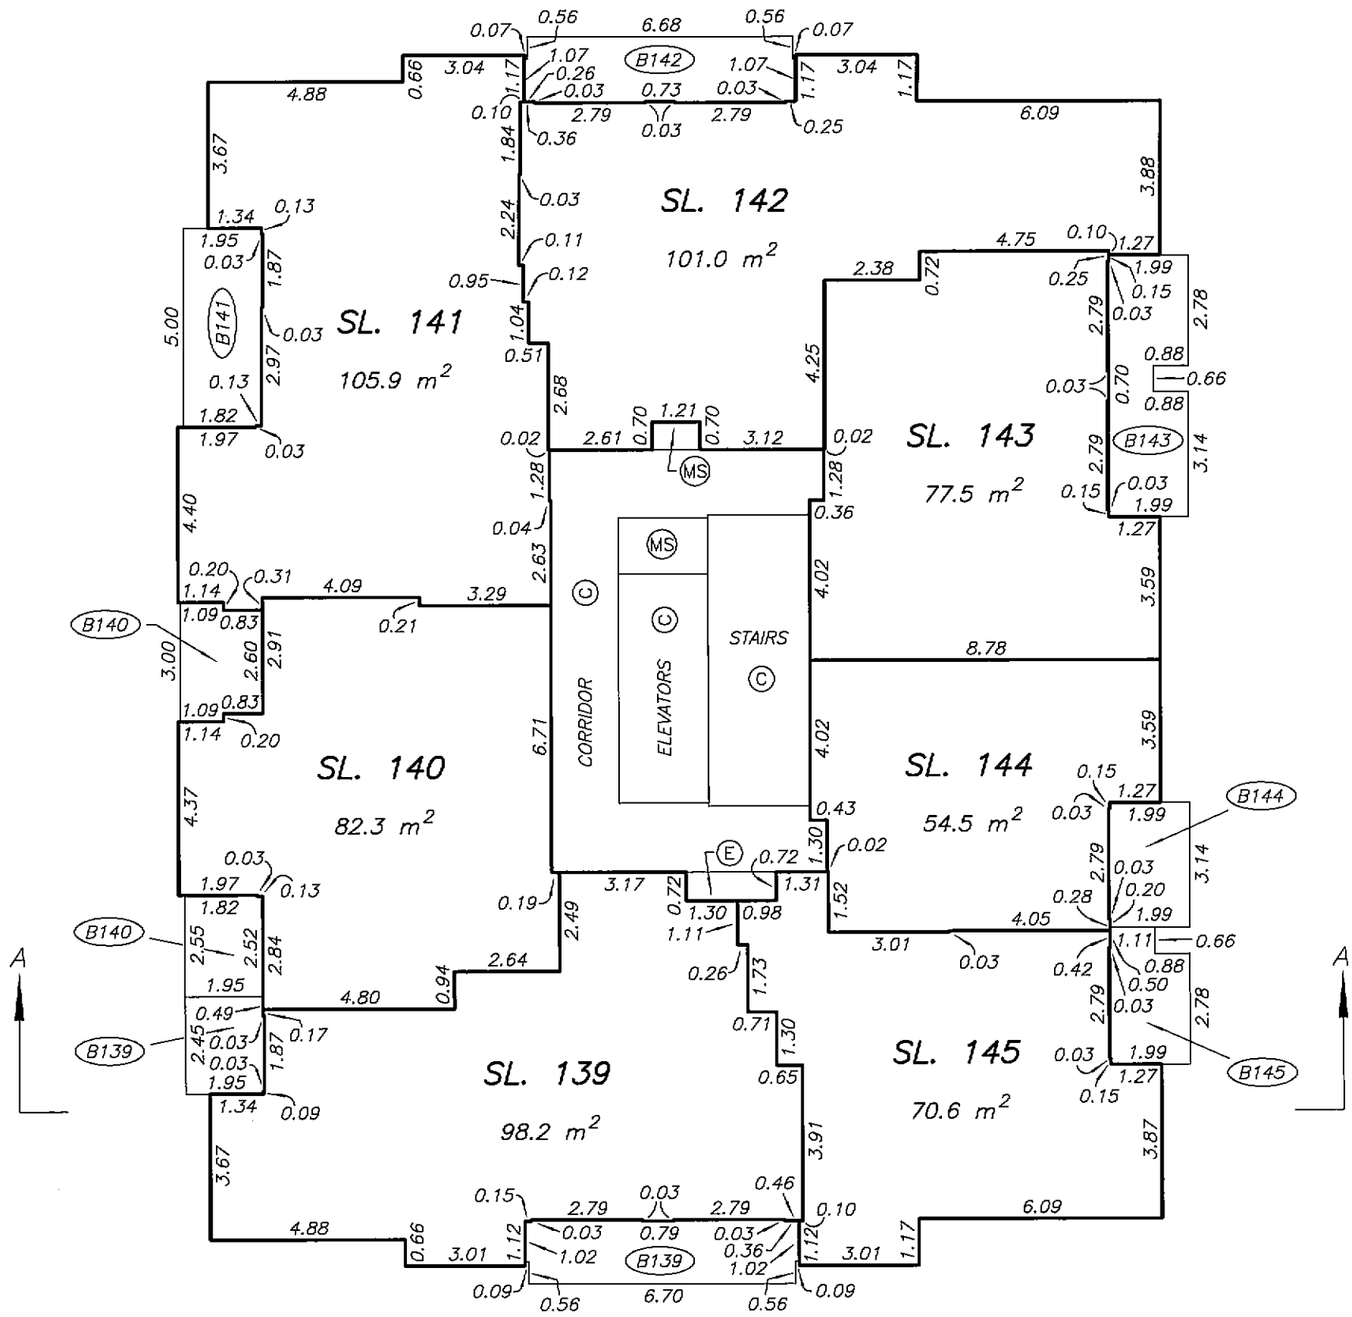

DATE : FEBRUARY 20, 2008

M.E.B.

DRAWING # 30624-10
FILE # 30624-10_L20

ORIGINAL

FILED NWBCS2855 RCVD:2008-04-16 RQST:2010-03-09-14.00.13.395

LEVEL 21 FLOOR PLAN

STRATA PLAN BCS 2855

SCALE 1:150

2 0 2 4 6

ALL DISTANCES ARE IN METRES.

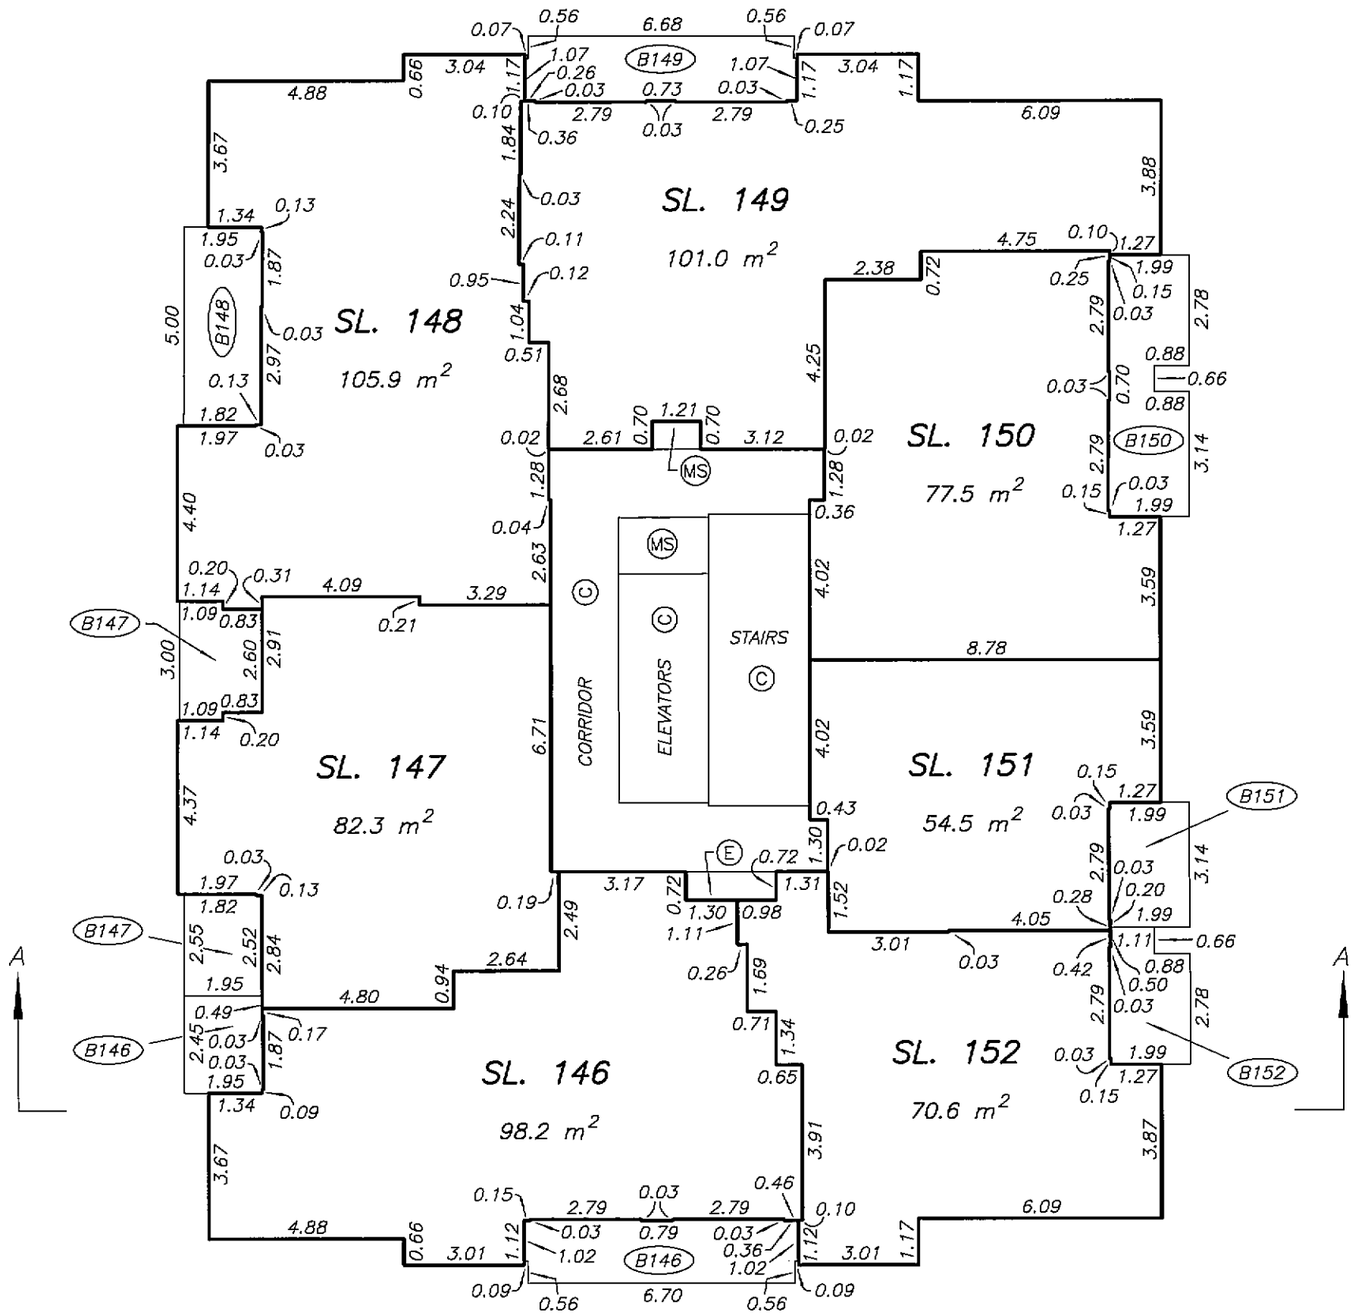

DATE : FEBRUARY 20, 2008

M.E.S.

DRAWING # 30624-10
FILE # 30624-10_L21

ORIGINAL

FILED NWBCS2855 RCVD:2008-04-16 RQST:2010-03-09-14.00.13.395

LEVEL 22 FLOOR PLAN

STRATA PLAN BCS 2855

SCALE 1:150

2 0 2 4 6

ALL DISTANCES ARE IN METRES.

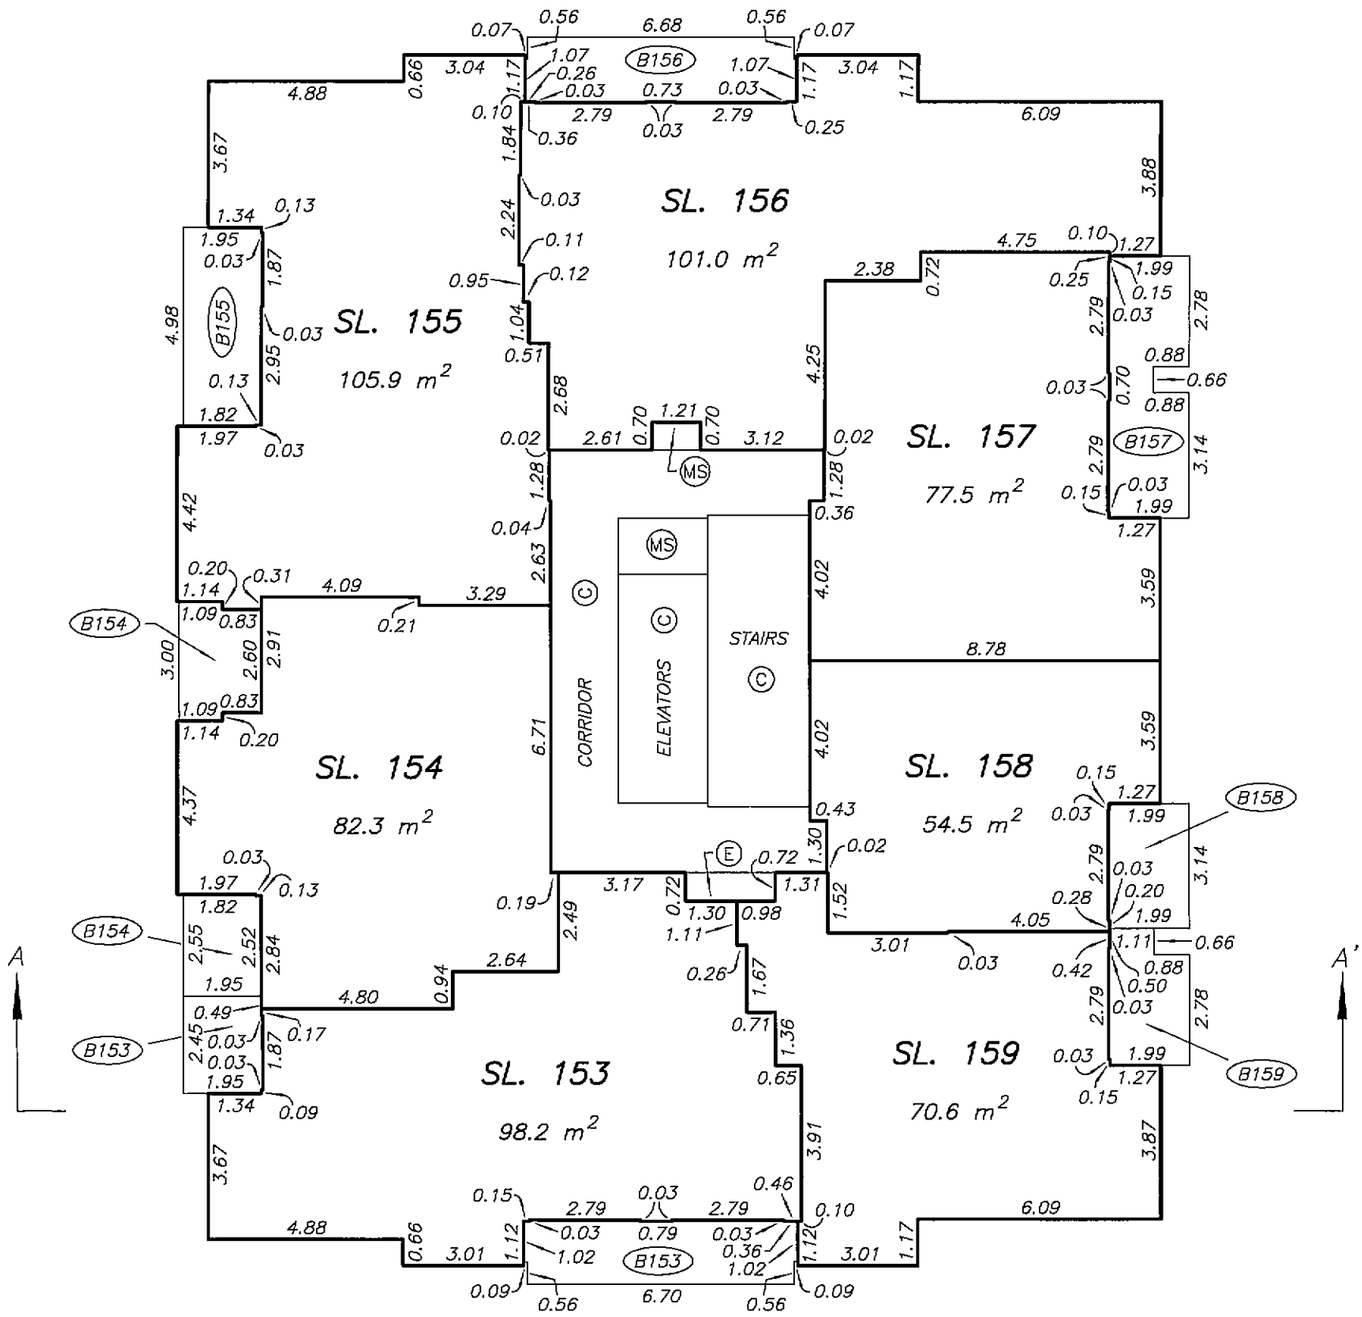

DATE : FEBRUARY 20, 2008

M.E.S.

DRAWING # 30624-10
FILE # 30624-10_L22

ORIGINAL

FILED NMBCS2855 RCVD:2008-04-16 RQST:2010-03-09-14.00.13.395

LEVEL 23 FLOOR PLAN

STRATA PLAN BCS 2855

SCALE 1:150

2 0 2 4 6

ALL DISTANCES ARE IN METRES.

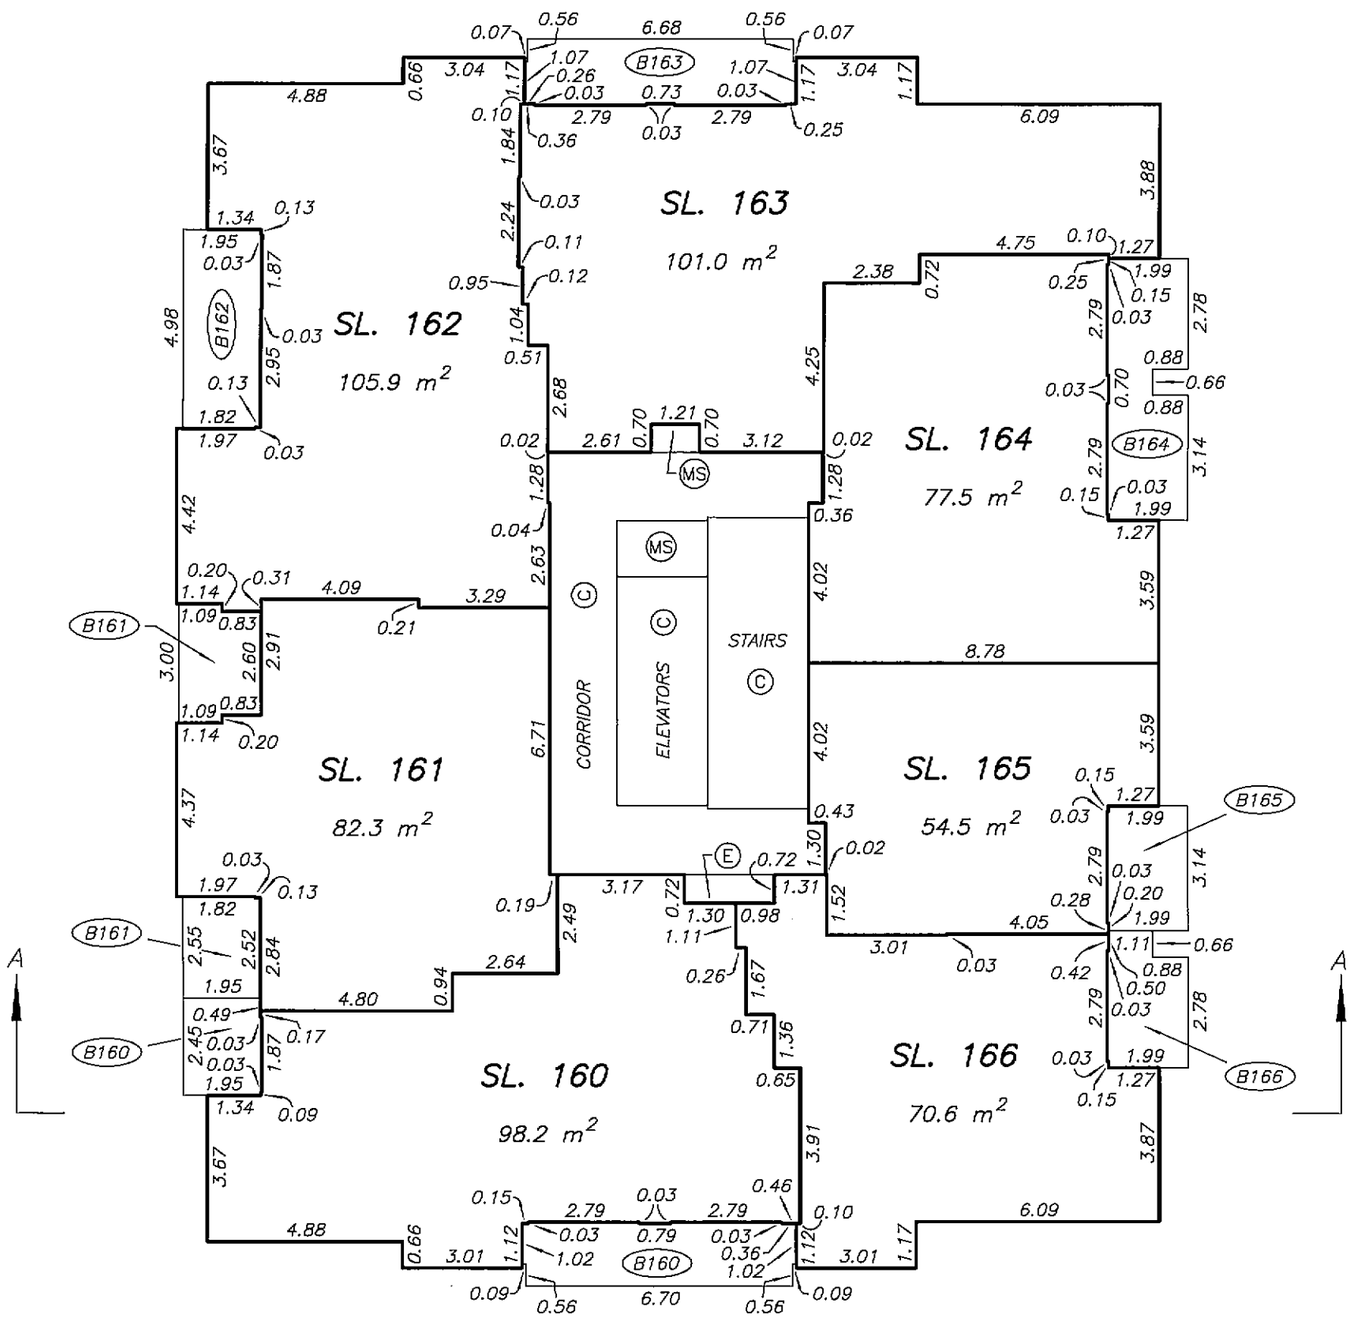

DRAWING # 30624-10
FILE # 30624-10_L23

DATE : FEBRUARY 20, 2008

M.E.S.

ORIGINAL

FILED NWBCS2855 RCVD:2008-04-16 RQST:2010-03-09-14.00.13.395

LEVEL 24 FLOOR PLAN

STRATA PLAN BCS 2855

SCALE 1:150

2 0 2 4 6

ALL DISTANCES ARE IN METRES.

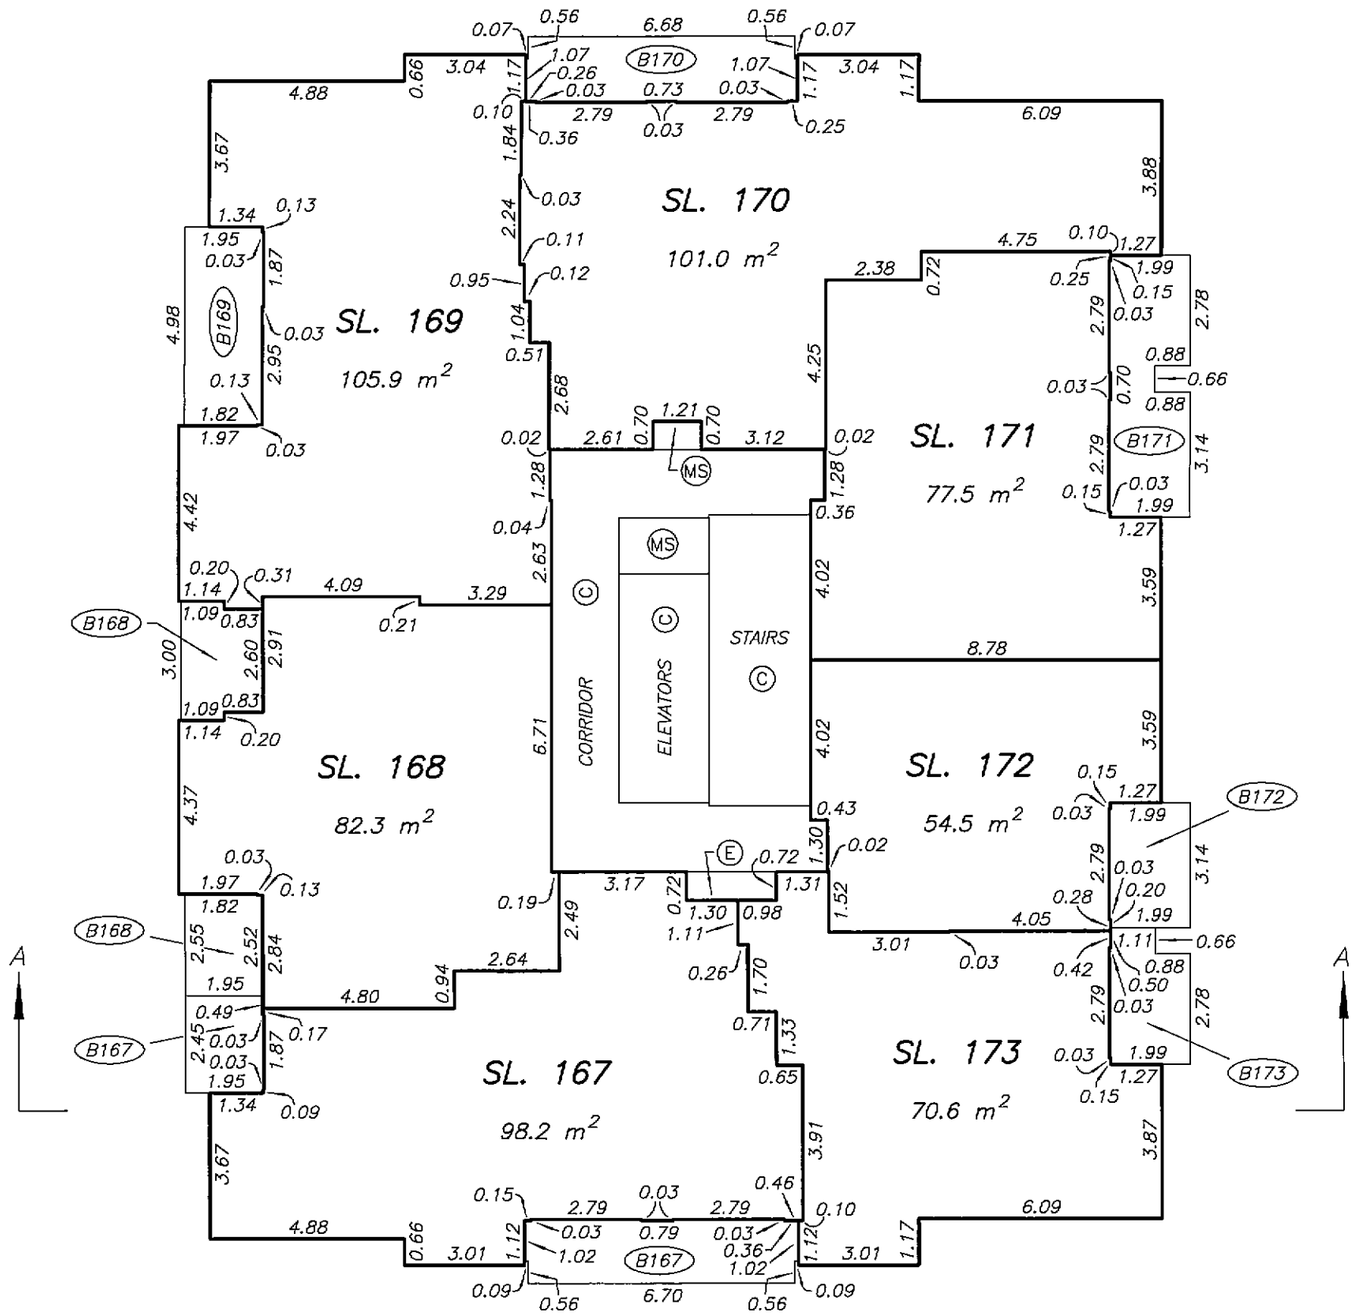

DATE : FEBRUARY 20, 2008

M.E.S.

DRAWING # 30624-10
FILE # 30624-10_L24

ORIGINAL

FILED NWBCS2855 RCVD:2008-04-16 RQST:2010-03-09-14.00.13.395

LEVEL 25 FLOOR PLAN

STRATA PLAN BCS 2855

SCALE 1:150

2 0 2 4 6

ALL DISTANCES ARE IN METRES.

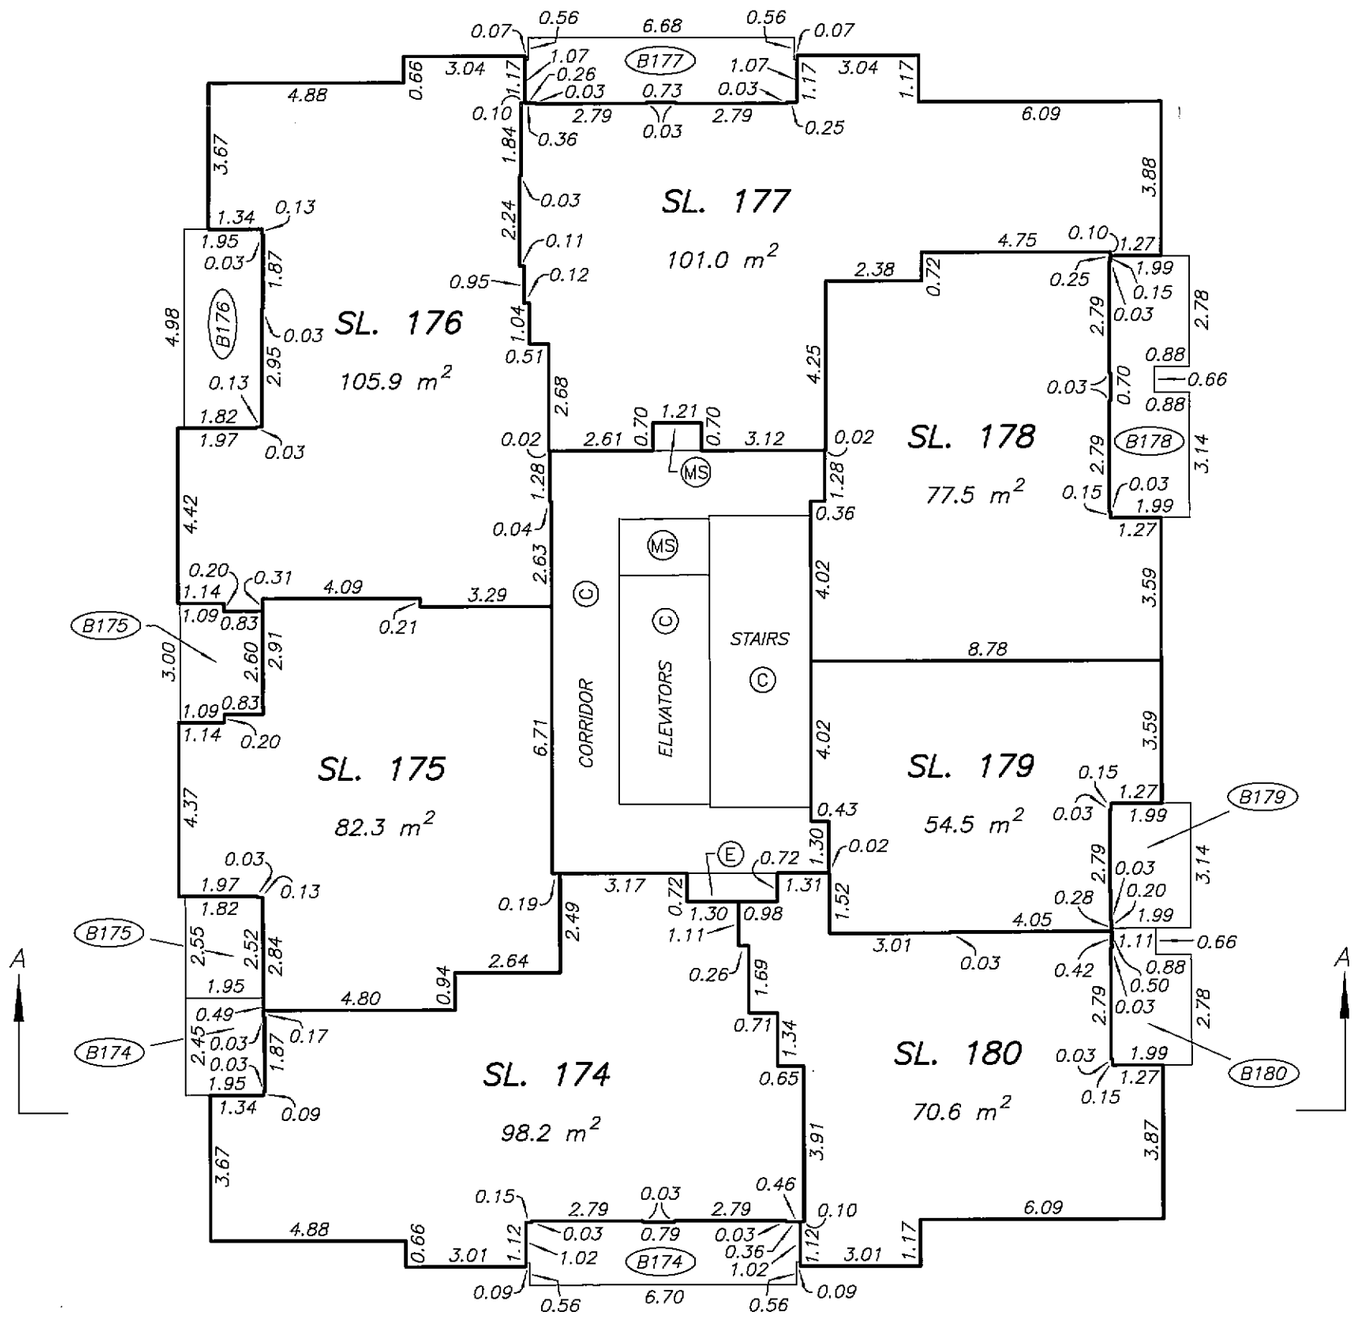

DATE : FEBRUARY 20, 2008

M.E.B.

DRAWING # 30624-10
FILE # 30624-10_L25

ORIGINAL

FILED NWBCS2855 RCVD:2008-04-16 RQST:2010-03-09-14.00.13.395

LEVEL 26 FLOOR PLAN

STRATA PLAN BCS 2855

SCALE 1:150

2 0 2 4 6

ALL DISTANCES ARE IN METRES.

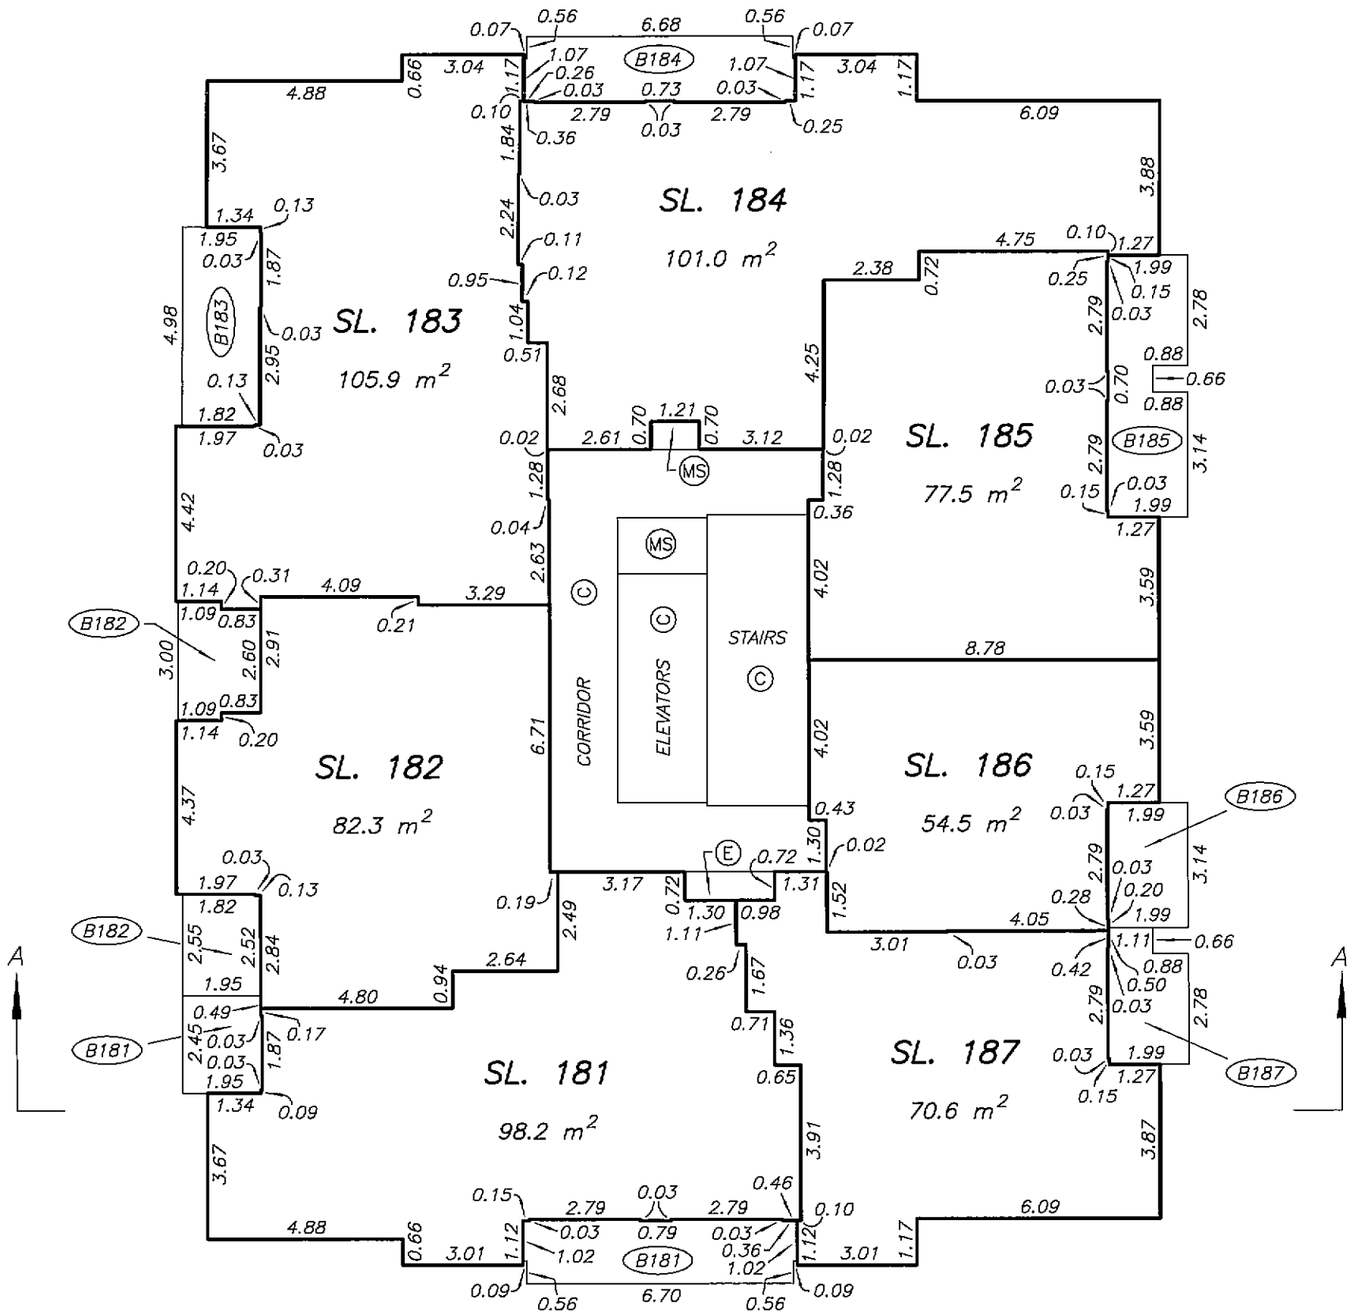

DATE : FEBRUARY 20, 2008

M.E.S.

DRAWING # 30624-10
FILE # 30624-10_L26

ORIGINAL

FILED NMBCS2855 RCVD:2008-04-16 RQST:2010-03-09-14.00.13.395

LEVEL 27 FLOOR PLAN

STRATA PLAN BCS 2855

SCALE 1:150

2 0 2 4 6

ALL DISTANCES ARE IN METRES.

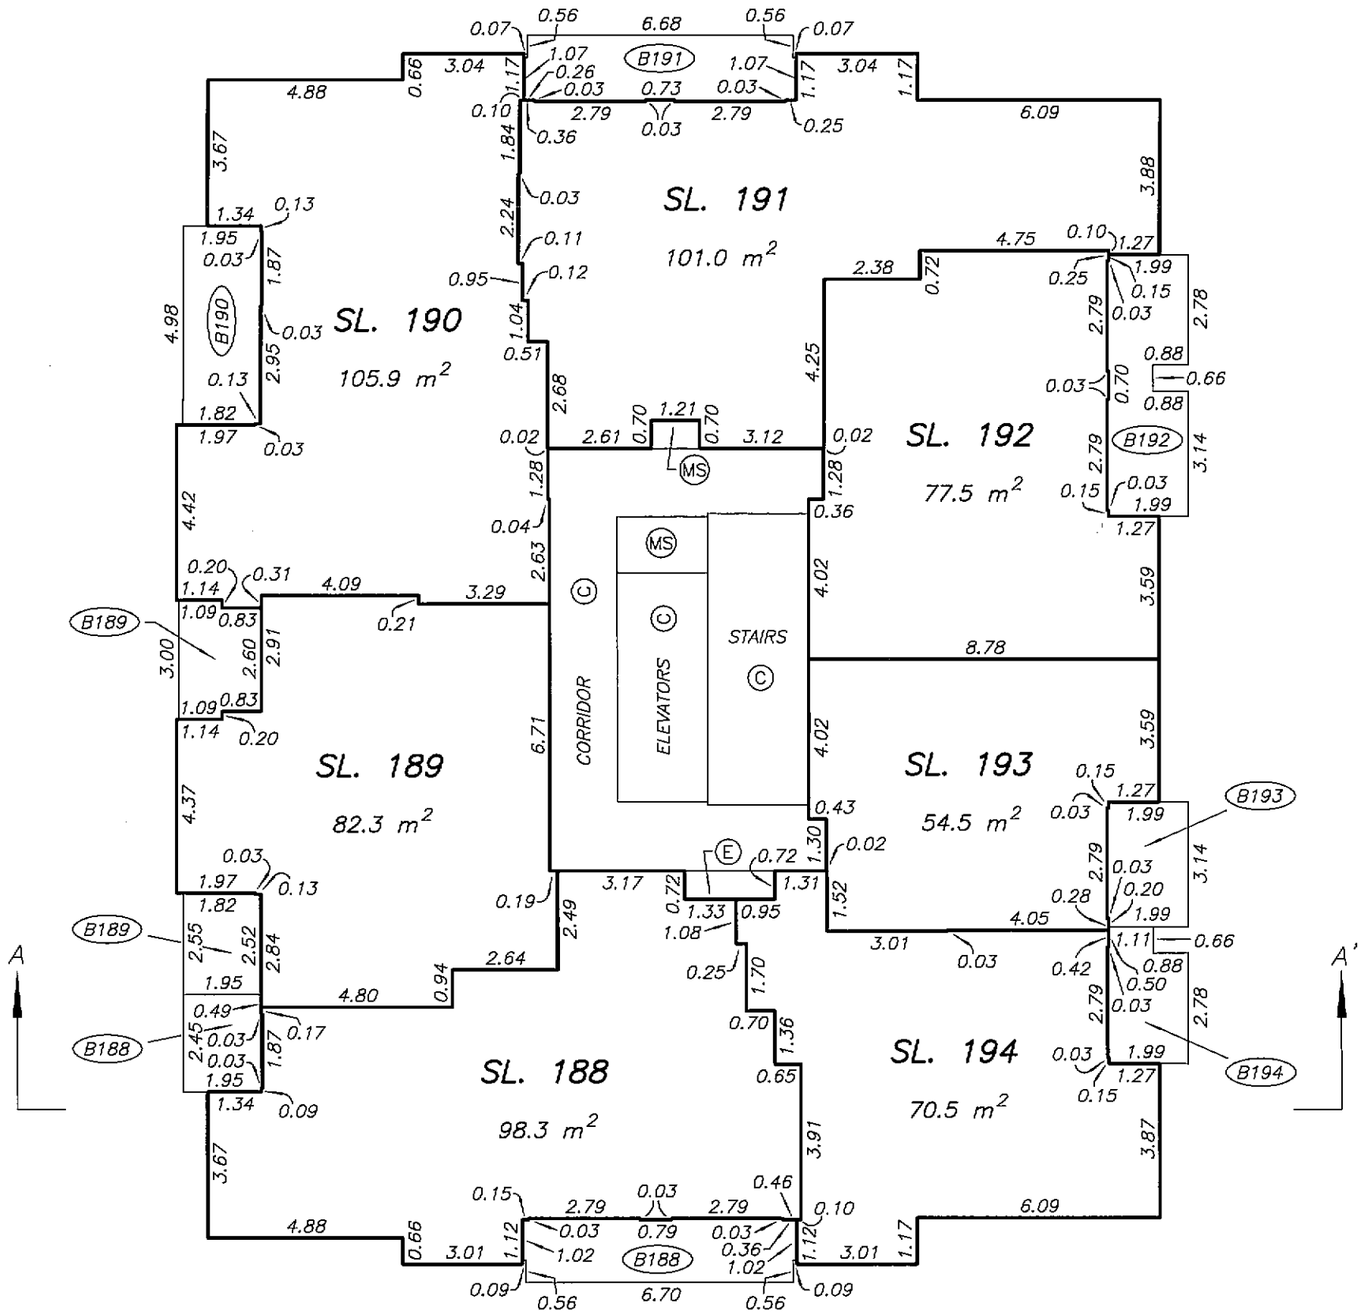

DATE : FEBRUARY 20, 2008

M.E.B.

DRAWING # 30624-10
FILE # 30624-10_L27

ORIGINAL

FILED NWBCS2855 RCVD:2008-04-16 RQST:2010-03-09-14.00.13.395

LEVEL 28 FLOOR PLAN

STRATA PLAN BCS 2855

SCALE 1:150

2 0 2 4 6

ALL DISTANCES ARE IN METRES.

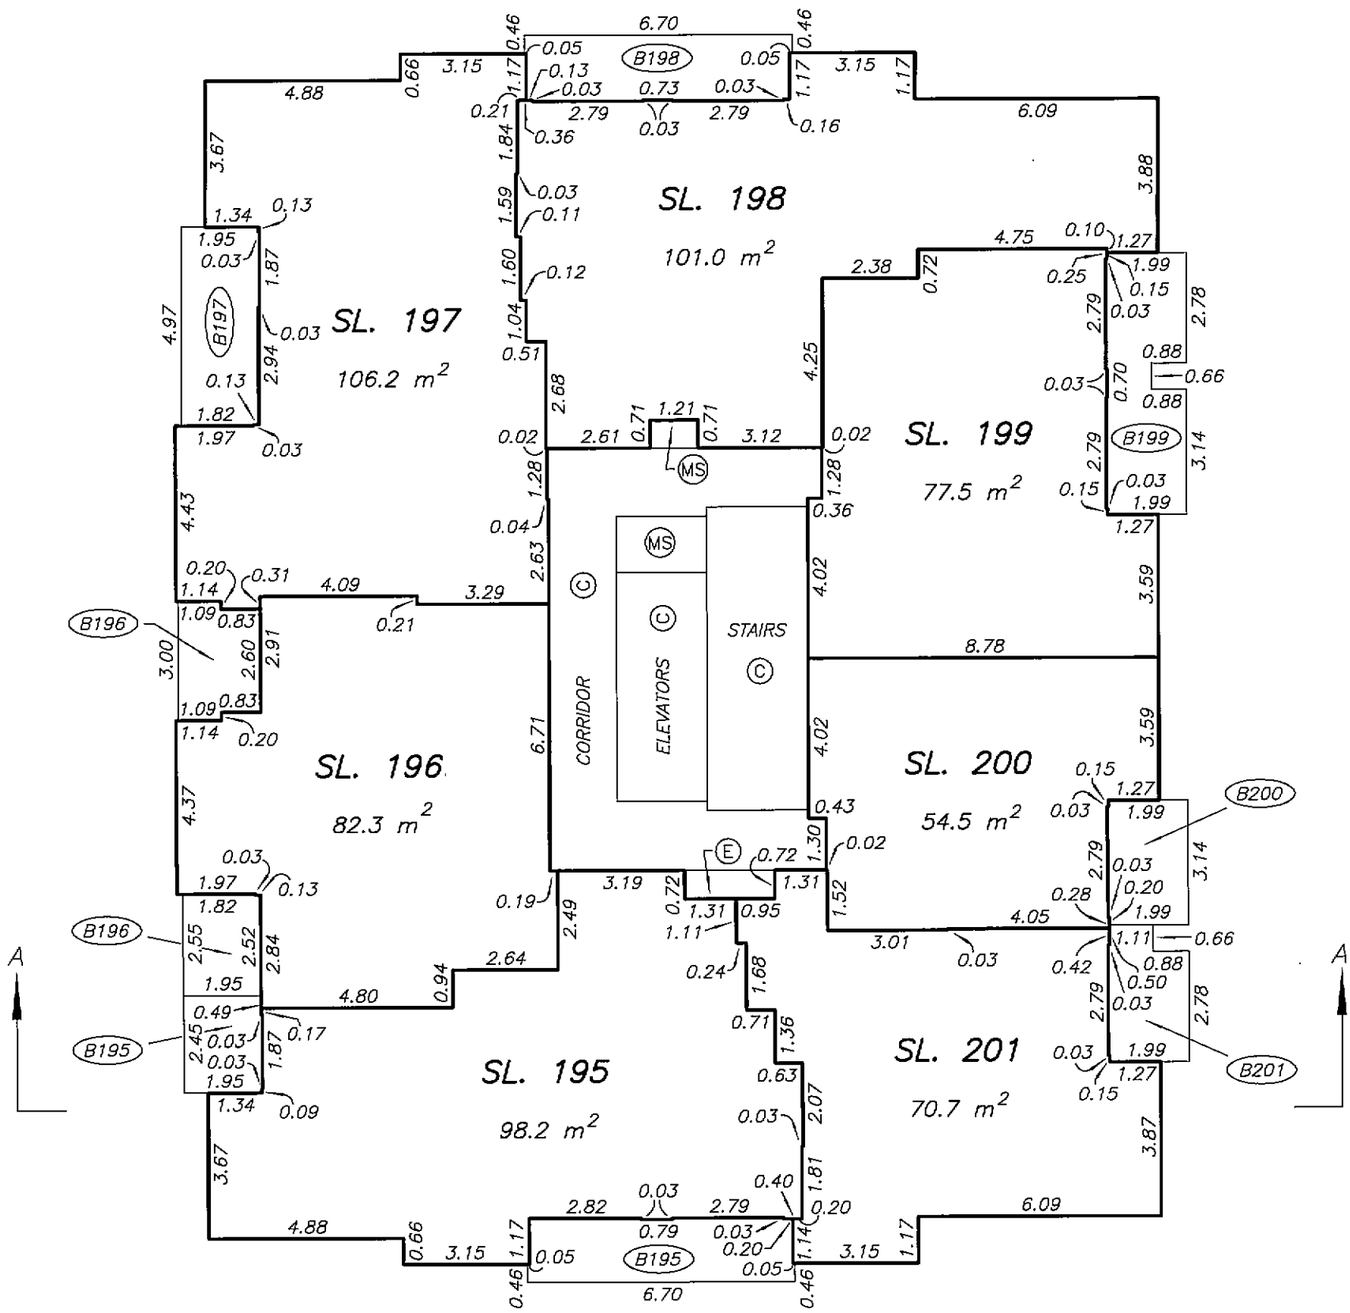

DATE : FEBRUARY 20, 2008

M.E.S.

DRAWING # 30624-10
FILE # 30624-10_L28

ORIGINAL

FILED NWBCS2855 RCVD:2008-04-16 RQST:2010-03-09-14.00.13.395

LEVEL 29 FLOOR PLAN

STRATA PLAN BCS 2855

SCALE 1:150

2 0 2 4 6

ALL DISTANCES ARE IN METRES.

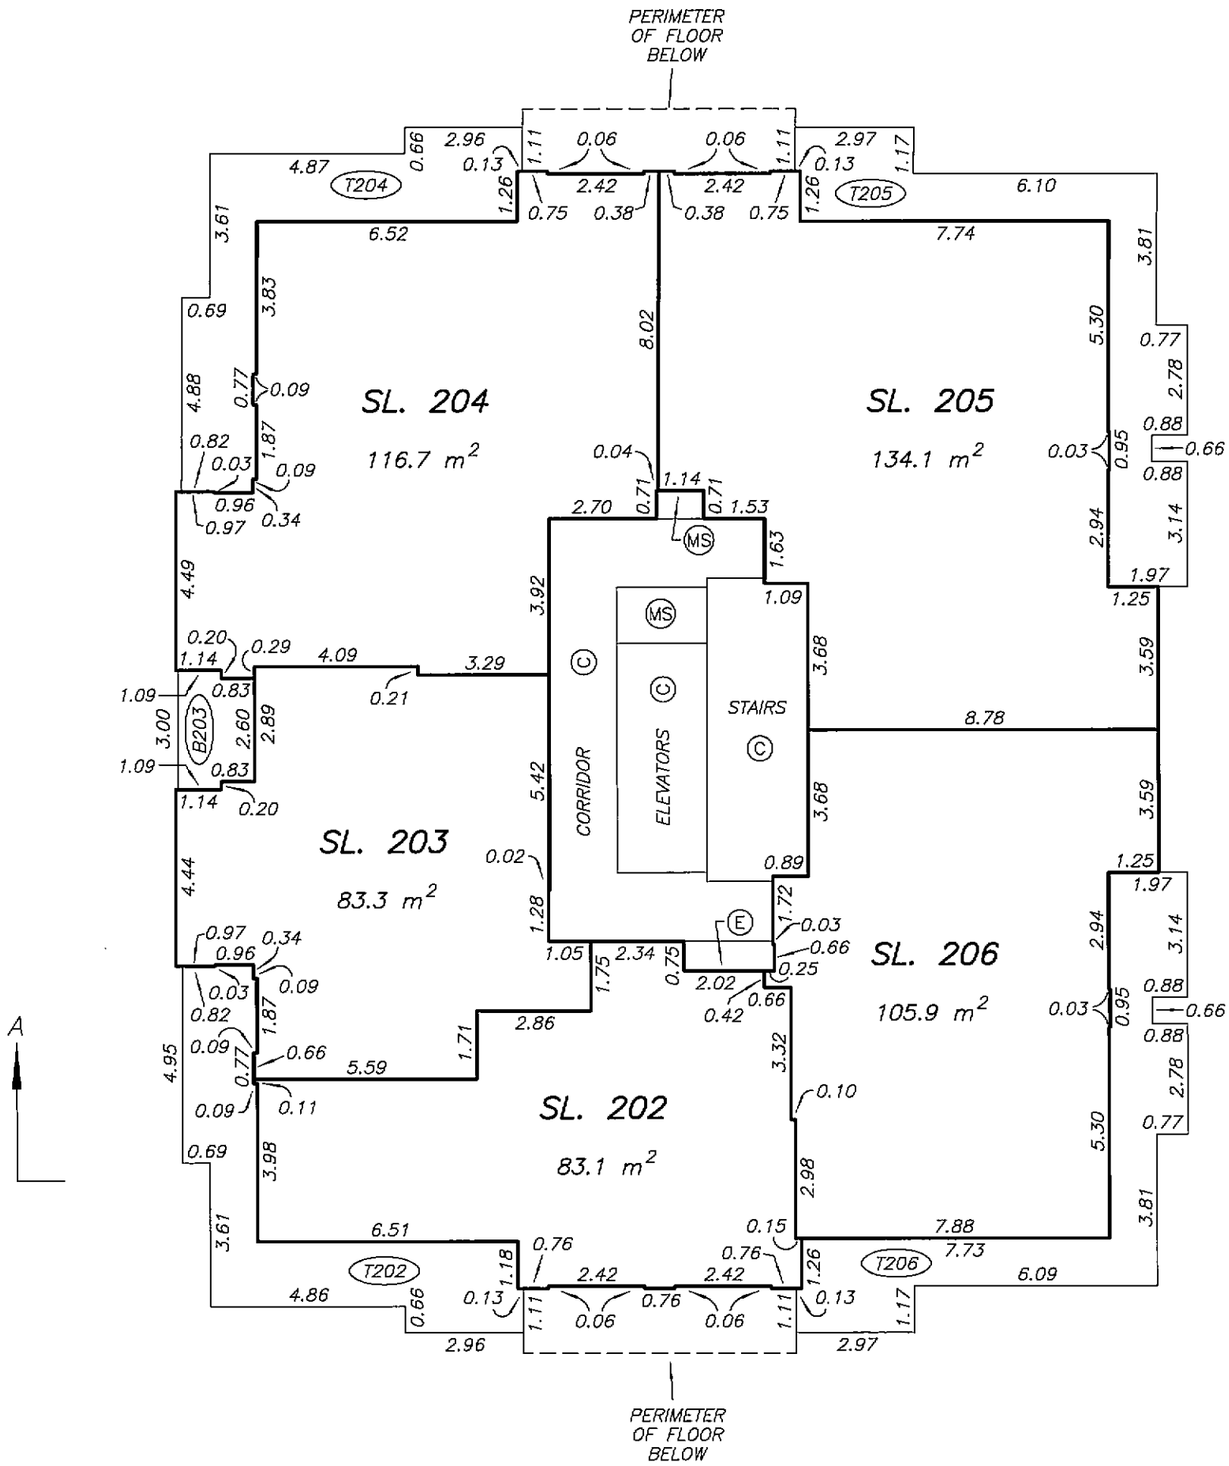

DATE : FEBRUARY 20, 2008

M.E.S.

DRAWING # 30624-10
FILE # 30624-10_L29

ORIGINAL

FILED NWBCS2855 RCVD:2008-04-16 RQST:2010-03-09-14.00.13.395

LEVEL 30 FLOOR PLAN

STRATA PLAN BCS 2855

SCALE 1:150

2 0 2 4 6

ALL DISTANCES ARE IN METRES.

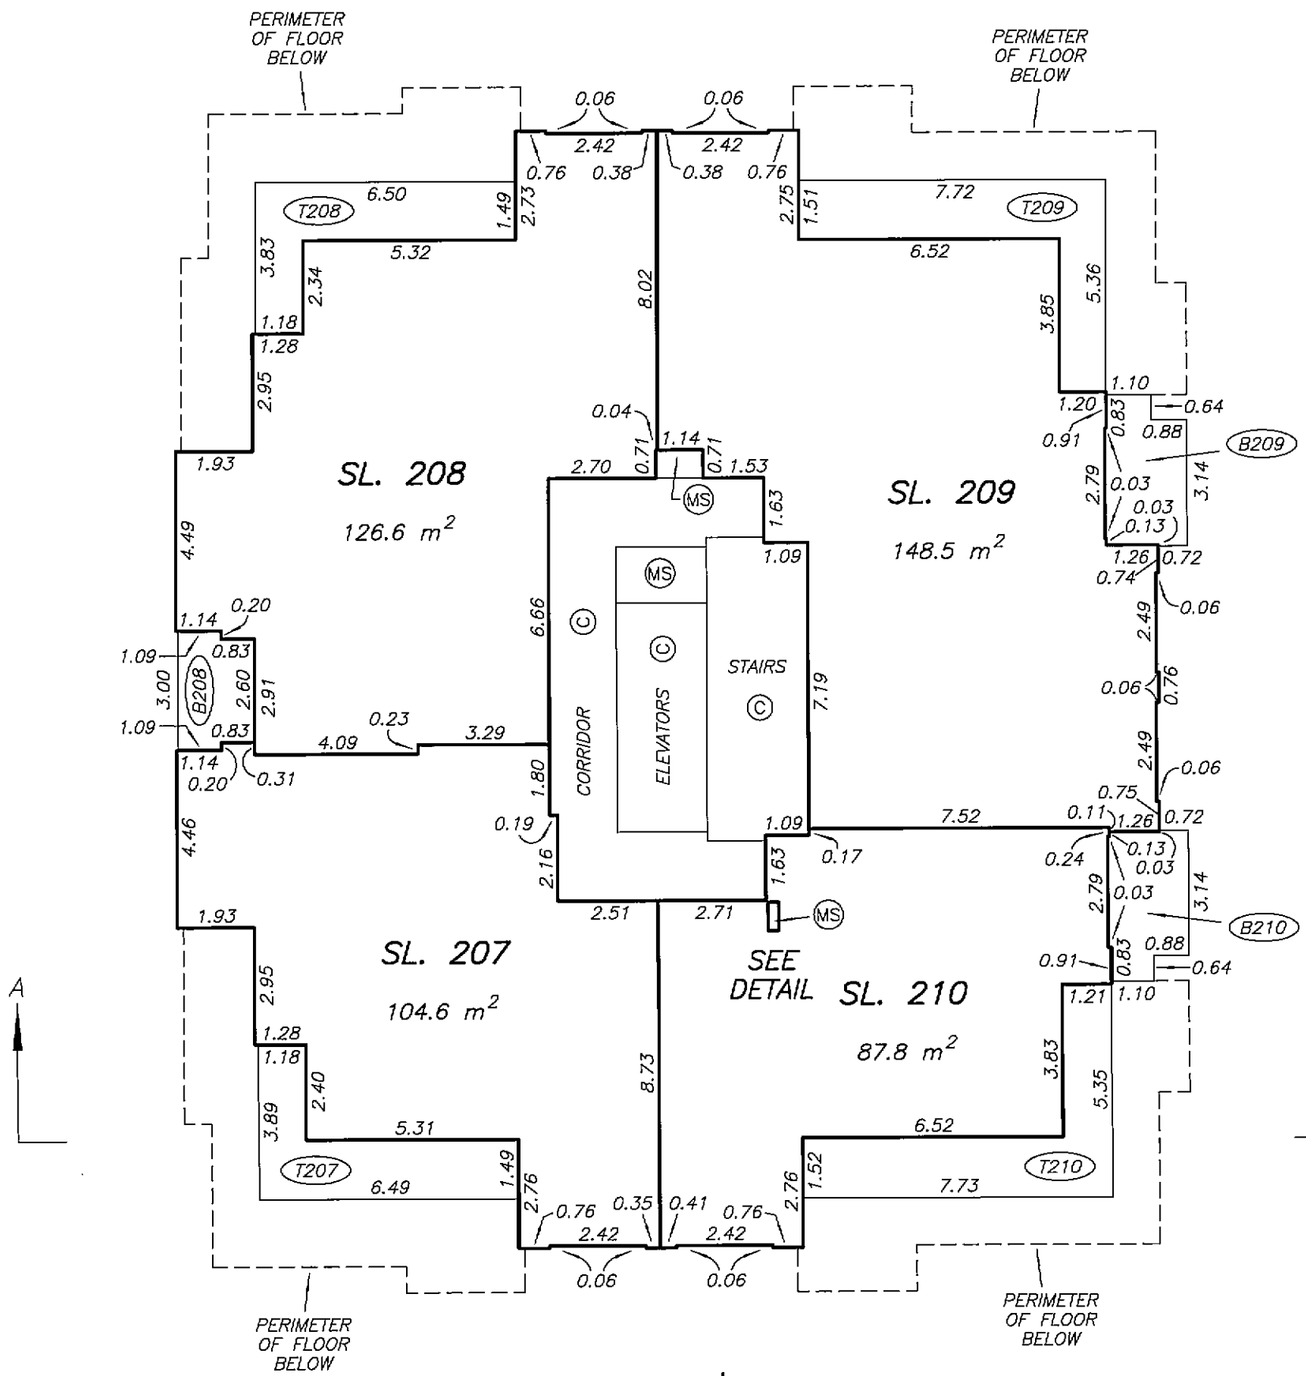

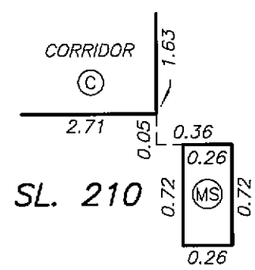

DETAIL

NOT TO SCALE

DATE : FEBRUARY 20, 2008

M.E.S.

DRAWING # 30624-10
FILE # 30624-10_L30

ORIGINAL

FILED NMBCS2855 RCVD:2008-04-16 RQST:2010-03-09-14.00.13.395

LEVEL 31 FLOOR PLAN

STRATA PLAN BCS 2855

SCALE 1:150

2 0 2 4 6

ALL DISTANCES ARE IN METRES.

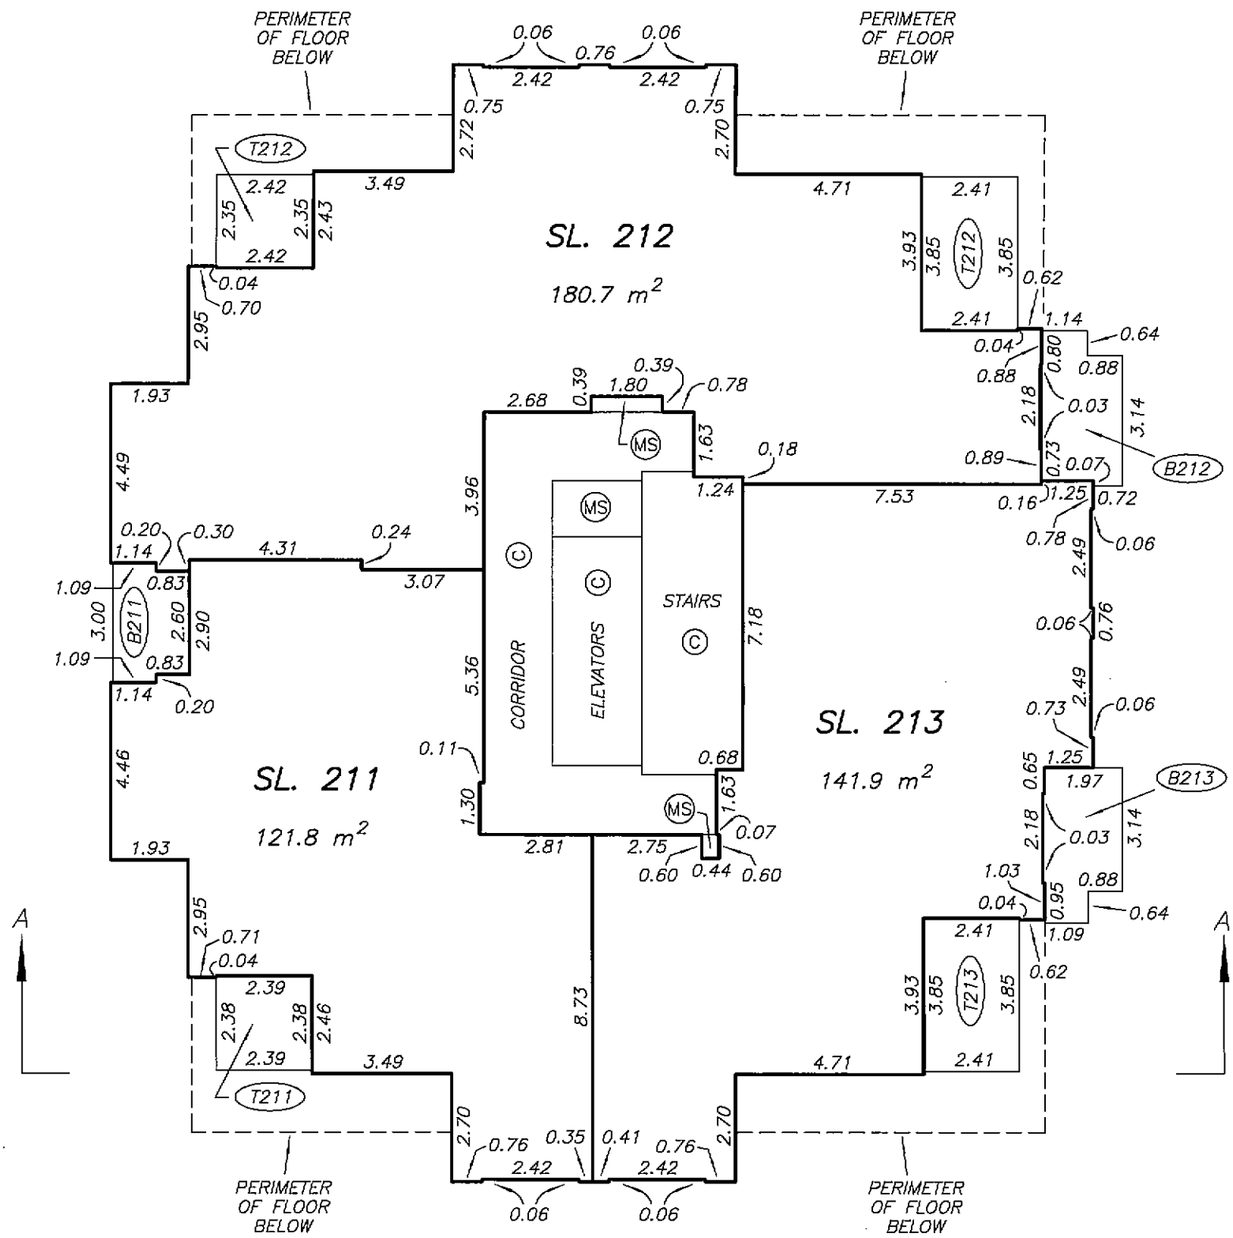

DATE : FEBRUARY 20, 2008

M.E.B.

DRAWING # 30624-10
FILE # 30624-10_L31

ORIGINAL

FILED NMBCS2855 RCVD:2008-04-16 RQST:2010-03-09-14.00.13.395

ROOF LEVEL

STRATA PLAN BCS 2855

SCALE 1:150

2 0 2 4 6

ALL DISTANCES ARE IN METRES.

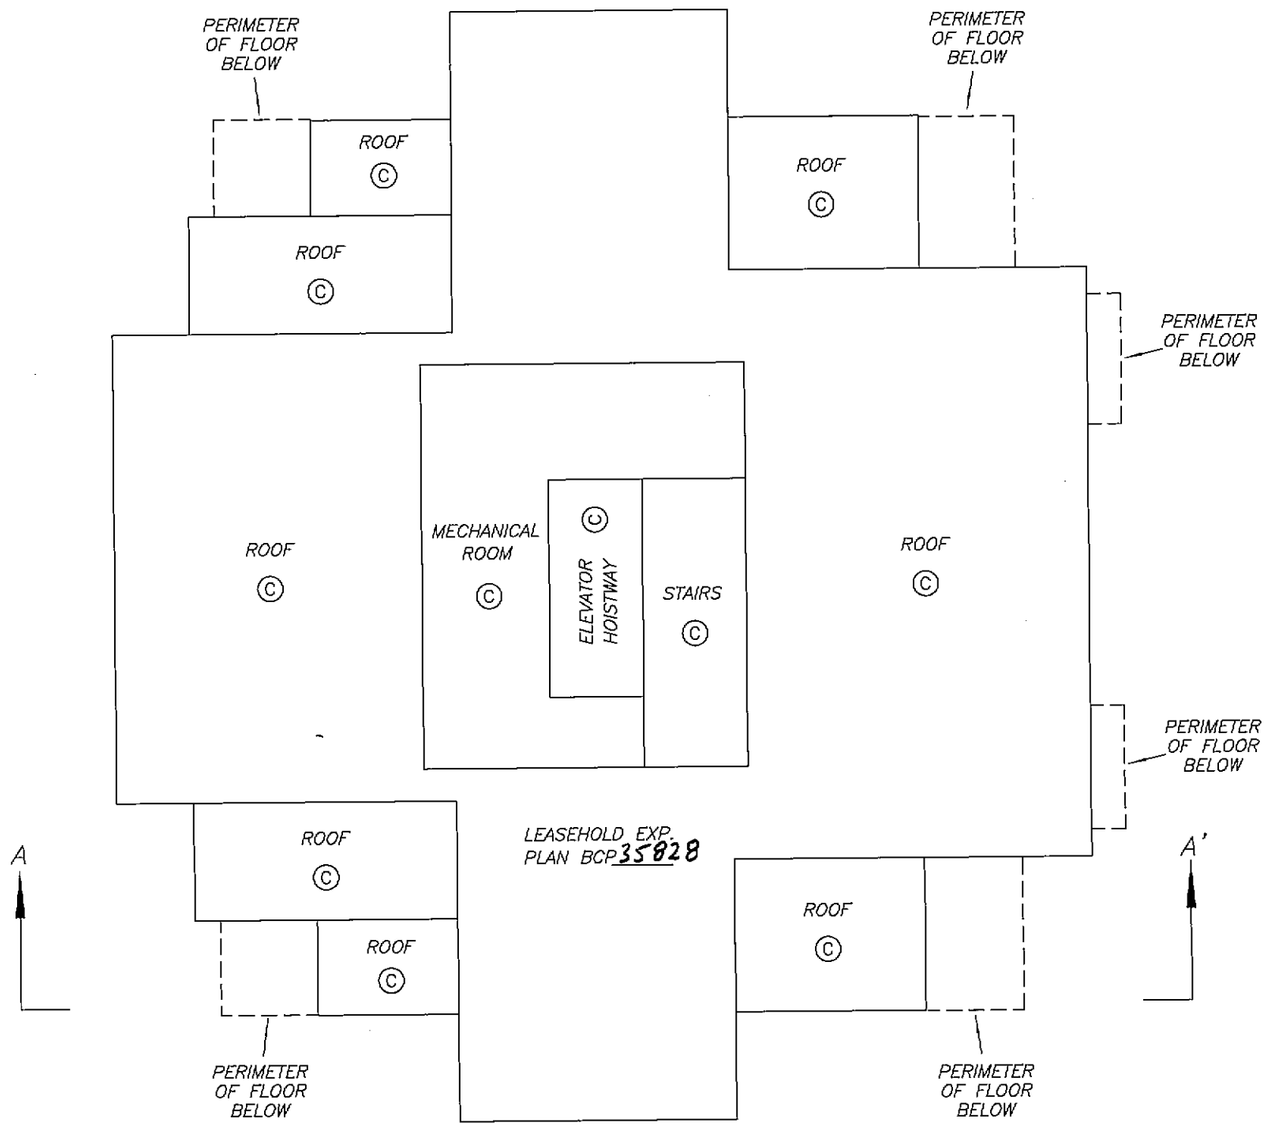

DATE : FEBRUARY 20, 2008

M.E.B.

DRAWING # 30624-10
FILE # 30624-10_L32

ORIGINAL

FILED NWBCS2855 RCVD:2008-04-16 RQST:2010-03-09-14.00.13.395

ELEVATOR MACHINE ROOM LEVEL

STRATA PLAN BCS 2855

SCALE 1:150

2 0 2 4 6

ALL DISTANCES ARE IN METRES.

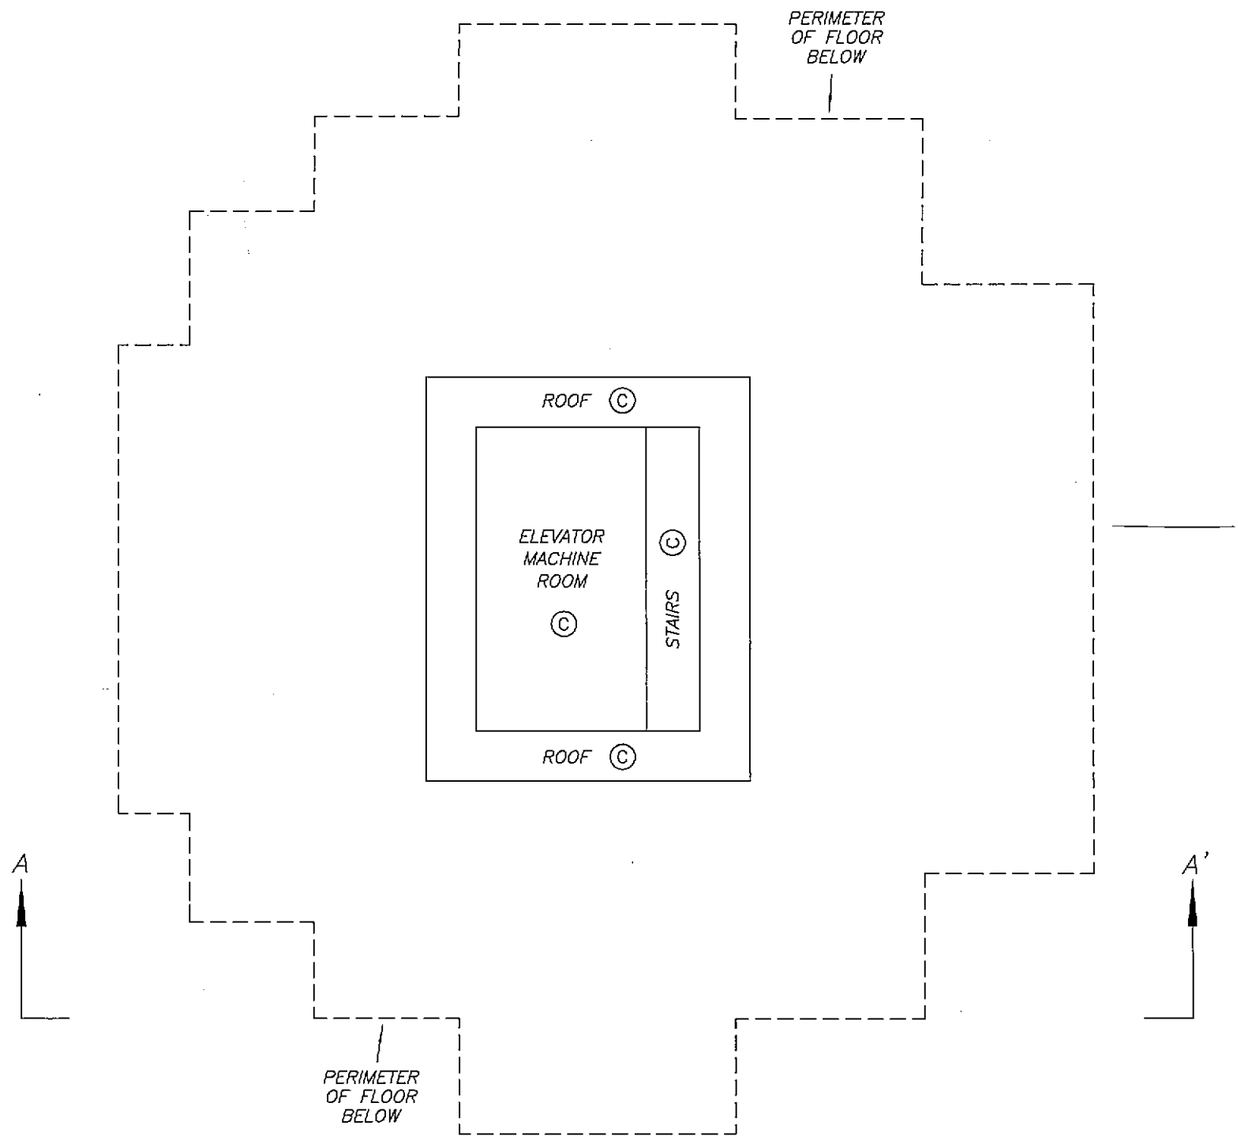

DATE : FEBRUARY 20, 2008

M.E.S.

DRAWING # 30624-10
FILE # 30624-10_L33

ORIGINAL

FILED NMBCS2855 RCVD:2008-04-16 RQST:2010-03-09-14.00.13.395